

Pike

MISSISSIPPI  
BOARD OF WATER COMMISSIONERS  
416 North State Street  
Jackson, Mississippi 39201

M 2029  
4-29-80

WATER WELL DRILLERS LOG

4-29 1980  
date well completed

Fitzgerald Well Serv  
firm name

Pike  
county well located

LANDOWNER:

Clyde Jones

R.B. Moser  
(mailing address)

description of formations encountered

from to

Red Clay	0	20
Red sand & gravel	20	115
Coarse sand & gravel	115	126

WELL LOCATION:

sec. 15 T 1 N R 9 E  
S W  
3 miles W of Silver Lake  
(distance) (direction) (nearest town)

WELL PURPOSE: Home  
(home, irrigation, municipal, industrial)

WELL COMPLETION DATA:

- (1) diameter (inches) 4
- (2) total depth (feet) 126
- (3) static water level (feet) 90 below top of ground.
- (4) casing PVC, 118, (material) (depth)  
4 (size) if telescope see back.
- (5) screen 8, 118 (length) (depth to top)  
4, PVC (size) (material)
- (6) pump 1/2 (HP) 10 (yield gpm)  
4 (type power)
- (7) electric log (yes or no)
- (8) how well bottom plugged sand block

DRILLERS REMARKS:


DEPT. OF NATURAL RESOURCES  
BUREAU OF LAND & WATER RESOURCES

JUN 20 1980

RECEIVED

If well telescopes please sketch and show depths.

GROUND LEVEL

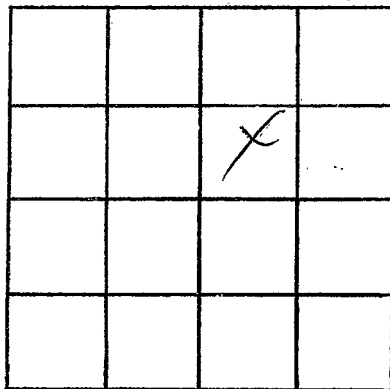

SECTION 15

Please indicate well location X.

ADDITIONAL INFORMATION

If more than one screen, show locations of each on sketch.