

PEKE
 M 2031
 7-25-80
 April 25

MISSISSIPPI
 BOARD OF WATER COMMISSIONERS
 416 North State Street
 Jackson, Mississippi 39201

WATER WELL DRILLERS LOG

~~1980~~ 1980 Reynolds Well Ser Pike
 date well completed firm name county well located

LANDOWNER:
Phillip's Dunn
Rt. Magnolia
 (mailing address)

description of formations encountered	from	to
<u>Red Clay</u>	<u>0</u>	<u>22</u>
<u>Red sand</u>	<u>22</u>	<u>78</u>
<u>sand + gravel</u>	<u>78</u>	<u>96</u>
<u>pink Chalk</u>	<u>96</u>	<u>110</u>
<u>sand + gravel</u>	<u>110</u>	<u>125</u>

WELL LOCATION:
 sec. 7 T. 1 N. R. 9 E
2 miles N-NW of Progers
 (distance) (direction) (nearest town)

WELL PURPOSE: Tractor
 (home, irrigation, municipal, industrial)

WELL COMPLETION DATA:
 (1) diameter (inches) 4"
 (2) total depth (feet) 125
 (3) static water level (feet) 96 below above top of ground.
 (4) casing plastic bottom
 (material) (depth)
 (size) if telescope see back.
 (5) screen 5" 120'
 (length) (depth to top)
4" plastic
 (size) (material)
 (6) pump by others
 (HP) (yield gpm)
skt
 (type power)
 (7) electric log no
 (yes or no)
 (organization running log)

(8) how well bottom plugged beach wash valve

DRILLERS REMARKS:


DEPT. OF NATURAL RESOURCES
 BUREAU OF LAND & WATER RESOURCES

JAN 12 1981

RECEIVED

If well telescopes please sketch and show depths.

GROUND LEVEL

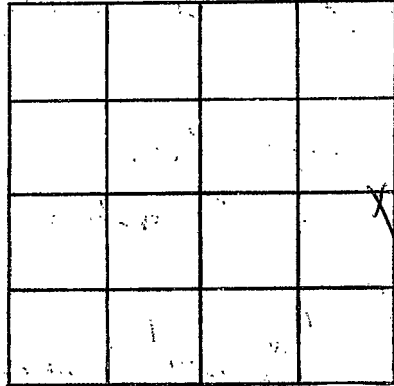

SECTION 7

Please indicate well location X.

ADDITIONAL INFORMATION

If more than one screen,
show locations of each on sketch.