


PEKE  
 M 2032  
 6-14-80  
 June 14 1980  
 date well completed

MISSISSIPPI  
 BOARD OF WATER COMMISSIONERS  
 416 North State Street  
 Jackson, Mississippi 39201

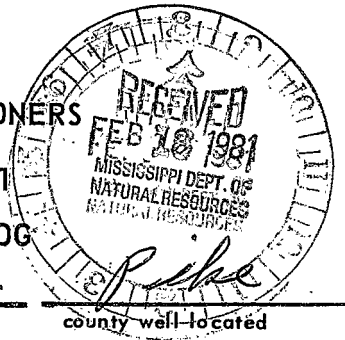


WATER WELL DRILLERS LOG

80 Reems Miller  
 firm name

county well located

LANDOWNER:	description of formations encountered	from	to
Sena Allen Rt 2 M. G. Combe (mailing address)	Red Clay loamy sand Red sand sand + gravel	0	27 27 75 100
<b>WELL LOCATION:</b>			
sec. 7 T. 1 N R. 9 E 1 1/2 miles N-NW of Progress (distance) (direction) (nearest town)			
<b>WELL PURPOSE:</b> <u>farm</u> (home, irrigation, municipal, industrial)			
<b>WELL COMPLETION DATA:</b>			
(1) diameter (inches) <u>4"</u>			
(2) total depth (feet) <u>114'</u>			
(3) static water level (feet) <u>99'</u> below top of ground			
(4) casing <u>plastic bottom</u> (material) (depth)			
_____ If telescope see back. (size)			
(5) screen <u>5'</u> <u>109'</u> (length) (depth to top)			
<u>4"</u> <u>Plastic</u> (size) (material)			
(6) pump <u>Sub</u> <u>10</u> (HP) (yield gpm)			
<u>elect</u> (type power)			
(7) electric log <u>no</u> (yes or no)			
_____ (organization running log)			
(8) how well bottom plugged <u>back wash valve</u>			
<b>DRILLERS REMARKS:</b> ✓			

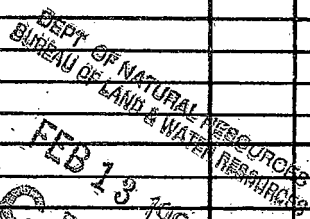

If well telescopes please sketch and show depths.

GROUND LEVEL

			X

SECTION 7

Please indicate well location X.

ADDITIONAL INFORMATION

If more than one screen, show locations of each on sketch.