

MISSISSIPPI DEPARTMENT OF NATURAL RESOURCES
Bureau of Land and Water Resources
 Southport Mall
 P.O. Box 10631
 Jackson, Mississippi 39209
WATER WELL DRILLERS LOG

12

PIKE
2034
M

Oct 29 1981 Acres well in Pike
 date well completed firm name county well located

LANDOWNER:
Mark Johnson
Rt 2 McCombs
 (mailing address)

description of formations encountered	from	to
<u>Red Clay</u>	<u>0</u>	<u>15</u>
<u>Sand & Gravel</u>	<u>15</u>	<u>45</u>
<u>Red Chalk & Lately</u>	<u>45</u>	<u>125</u>
<u>fine Gravel</u>	<u>115</u>	<u>125</u>
<u>sand</u>		

WELL LOCATION:
 sec. 26 T-1 N R-9 E
4 miles ESE of proprietor
 (distance) (direction) (nearest town)

WELL PURPOSE: home
 (home, irrigation, municipal, industrial)

- WELL COMPLETION DATA:**
- (1) diameter (inches) 4"
 - (2) total depth (feet) 125
 - (3) static water level (feet) 45 ^{below} ~~above~~ top of ground.
 - (4) casing plastic batton
 (material) (depth)
 (size) if telescope see back.
 - (5) screen 5' 120
 (length) (depth to top)
4" plastic
 (size) (material)
 - (6) pump 2HP 11
 (HP) (yield gpm)
shot
 (type power)
 - (7) electric log no
 (yes or no)
 (organization running log)
 - (8) how well bottom plugged back wash

DEPT. OF NATURAL RESOURCES
 BUREAU OF LAND & WATER RESOURCES


JUN 15 1982

RECEIVED

DRILLERS REMARKS:

If well telescopes please sketch and show depths.

GROUND LEVEL

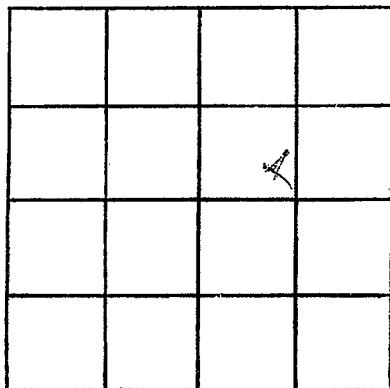

SECTION 2b

Please indicate well location X.

ADDITIONAL INFORMATION

If more than one screen,
show locations of each on sketch.