

MISSISSIPPI DEPARTMENT OF NATURAL RESOURCES

Bureau of Land and Water Resources

Southport Mall

P.O. Box 10631

Jackson, Mississippi 39209

WATER WELL DRILLERS LOG

Pike
M 2035
5/19/81

May 19 1981 Reems Well Dr Pike  
 date well completed firm name county well located

LANDOWNER:	description of formations encountered	from	to
<u>Shella Magee</u>			
<u>Rt 1 aspha</u> (mailing address)	<u>fine clay</u>	<u>0</u>	<u>8</u>
	<u>cherty sand</u>	<u>8</u>	<u>26</u>
	<u>coarse sand</u>	<u>26</u>	<u>60</u>

WELL LOCATION:  
 sec. 14 T 1 N R 9 E  
4 miles east of Proctor  
 (distance) (direction) (nearest town)

WELL PURPOSE: private  
 (home, irrigation, municipal, industrial)

WELL COMPLETION DATA:

(1) diameter (inches) 4 1/2

(2) total depth (feet) 60'

(3) static water level (feet) 24' below top of ground.

(4) casing plastic, leather  
 (material) (depth)

1/2" if telescope see back.  
 (size)

(5) screen 5' 55'  
 (length) (depth to top)

4" plastic  
 (size) (material)

(6) pump 1/2 10  
 (HP) (yield gpm)

split  
 (type power)

(7) electric log no  
 (yes or no)

          
 (organization running log)


(8) how well bottom plugged Back wash

DRILLERS REMARKS:         

DEPT OF NATURAL RESOURCES  
 BUREAU OF LAND & WATER RESOURCES  
 RECEIVED  
 NOV 2 - 1981

If well telescopes please sketch and show depths.

GROUND LEVEL

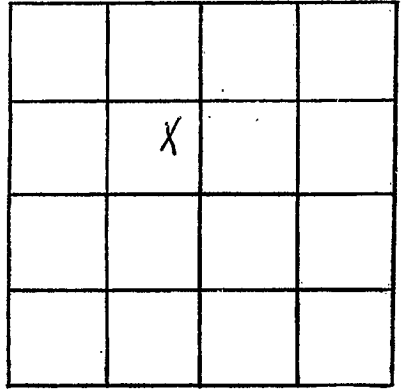

SECTION 14

Please indicate well location X.

ADDITIONAL INFORMATION

If more than one screen, show locations of each on sketch.