

MISSISSIPPI DEPARTMENT OF NATURAL RESOURCES
Bureau of Land and Water Resources
 Southport Mall
 P.O. Box 10631
 Jackson, Mississippi 39209
WATER WELL DRILLERS LOG

Pike
M
2035

Jan 21 1982 Rever Miller Pike
 date well completed firm name county well located

LANDOWNER:
Bobby Schilling
Rt 2 MC, Lomb
 (mailing address)

description of formations encountered	from	to
<u>Red sandy clay</u>	<u>0</u>	<u>16</u>
<u>loamy sand</u>	<u>16</u>	<u>20</u>
<u>sandy gravel</u>	<u>20</u>	<u>90</u>
<u>red chert</u>	<u>90</u>	<u>95</u>
<u>yellow sand</u>	<u>95</u>	<u>160</u>
<u>coarse sand</u>	<u>160</u>	<u>180</u>
<u>+ pea gravel</u>		

WELL LOCATION:
 sec. 34 T 1 N R 9 E
4 miles E.S.E. of Progre
 (distance) (direction) (nearest town)

WELL PURPOSE: Dairy
 (home, irrigation, municipal, industrial)

- WELL COMPLETION DATA:**
- (1) diameter (inches) 4"
 - (2) total depth (feet) 180
 - (3) static water level (feet) 90 below above top of ground.
 - (4) casing Plastic bottom
 (material) (depth)
 - (size) if telescope see back.
 - (5) screen 10' 170'
 (length) (depth to top)
 - (size) 4" plastic
 (material)
 - (6) pump 1/2 hp 19
 (HP) (yield gpm)
 - (type power) elec
 - (7) electric log no
 (yes or no)
 - (organization running log)

(8) how well bottom plugged
Back wash


DRILLERS REMARKS:
needed more water
extra well

DEPT. OF NATURAL RESOURCES
 BUREAU OF LAND & WATER RESOURCES

JUL - 1 1982
RECEIVED

If well telescopes please
sketch and show depths.

GROUND LEVEL

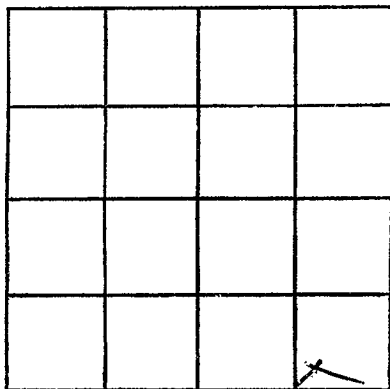

SECTION 34

Please indicate well location X.

ADDITIONAL INFORMATION

If more than one screen,
show locations of each on sketch.