

MISSISSIPPI DEPARTMENT OF NATURAL RESOURCES

Bureau of Land and Water Resources

Southport Mall

P.O. Box 10631

Jackson, Mississippi 39209

WATER WELL DRILLERS LOG

Pike
M
2044


April 14 1982 Reems Well Dr. Pike
 date well completed firm name county well located

LANDOWNER:	description of formations encountered	from	to
Ronnie Cleveland Rt 2 McComb (mailing address)			
WELL LOCATION: sec. <u>14</u> T <u>1</u> N R <u>9</u> E <u>3</u> miles <u>SSE</u> of <u>Proyer</u> (distance) (direction) (nearest town)			
WELL PURPOSE: (home, irrigation, municipal, industrial)			
WELL COMPLETION DATA:			
(1) diameter (inches) <u>4"</u>			
(2) total depth (feet) <u>132</u>			
(3) static water level (feet) <u>95</u> below top of ground.			
(4) casing <u>plaster bottom</u> (material) (depth)			
<u>-</u> if telescope see back. (size)			
(5) screen <u>5'</u> <u>127'</u> (length) (depth to top)			
<u>4"</u> <u>plaster</u> (size) (material)			
(6) pump <u>Weather</u> (HP) (yield gpm)			
<u>1/2 HP</u> (type power)			
(7) electric log <u>no</u> (yes or no)			
<u>-</u> (organization running log)			
(8) how well bottom plugged <u>brush wash</u>			
DRILLERS REMARKS:			

DEPT. OF NATURAL RESOURCES
 BUREAU OF LAND & WATER RESOURCES
 AUG - 5 1982
RECEIVED

If well telescopes please sketch and show depths.

GROUND LEVEL

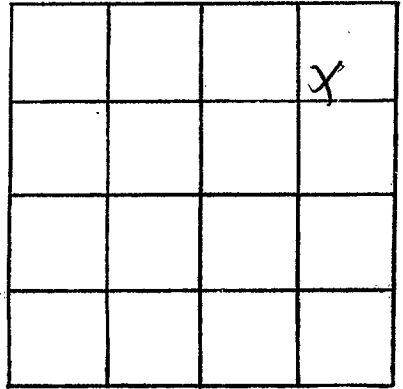

SECTION 14

Please indicate well location X.

ADDITIONAL INFORMATION

If more than one screen,
show locations of each on sketch.