

MISSISSIPPI DEPARTMENT OF NATURAL RESOURCES

Bureau of Land and Water Resources

Southport Mall

P.O. Box 10631

Jackson, Mississippi 39209

WATER WELL DRILLERS LOG

PIKE
M
2042

May 3 1982 Reems Miller Pike
date well completed firm name county well located

LANDOWNER:
Samuel Simmons
Rt 2 McLeade
(mailing address)

description of formations encountered	from	to
<u>Red Clay</u>	<u>0</u>	<u>10</u>
<u>sand & gravel</u>	<u>10</u>	<u>25</u>
<u>Chalky sand</u>	<u>25</u>	<u>40</u>
<u>gravel sand</u>	<u>40</u>	<u>98</u>

WELL LOCATION:
sec. 3 T 1 N R. 9 E
2 miles 3 Dyerscrossing
(distance) (direction) of (nearest town)

WELL PURPOSE: private
(home, irrigation, municipal, industrial)


- WELL COMPLETION DATA:
- (1) diameter (inches) 4"
 - (2) total depth (feet) 98
 - (3) static water level (feet) 55 below above top of ground.
 - (4) casing plastic bottom
(material) (depth)
 - if telescope see back.
(size)
 - (5) screen 5' 93'
(length) (depth to top)
 - 4" plastic
(size) (material)
 - (6) pump 1/2 hp 10
(HP) (yield gpm)
 - cbt
(type power)
 - (7) electric log no
(yes or no)
 - (organization running log)
 - (8) how well bottom plugged back wash

DRILLERS REMARKS:
—

DEPT. OF NATURAL RESOURCES
BUREAU OF LAND & WATER RESOURCES
AUG 5 1982
RECEIVED

If well telescopes please sketch and show depths.

GROUND LEVEL

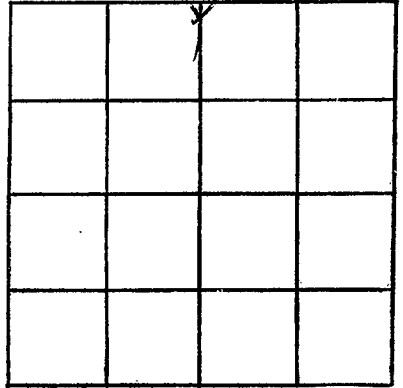

SECTION 3

Please indicate well location X.

ADDITIONAL INFORMATION

If more than one screen,
show locations of each on sketch.