

PILE
M
2043

MISSISSIPPI
 BOARD OF WATER COMMISSIONERS
 416 North State Street
 Jackson, Mississippi 39201

WATER WELL DRILLERS LOG

9-9 1982 Fitzgerald well Ser Pike
 date well completed firm name county well located

LANDOWNER:
Arnell Carter
R.R. Mozumil Mr.
 (mailing address)

description of formations encountered	from to	
<u>Red clay</u>	<u>0</u>	<u>20</u>
<u>Red sand</u>	<u>20</u>	<u>120</u>
<u>Coarse sand & gravel</u>	<u>120</u>	<u>140</u>

WELL LOCATION:
 sec. 10 T 1 N R 9 E
 S W
4 miles E of Preyers
 (distance) (direction) (nearest town)

WELL PURPOSE:
Home
 (home, irrigation, municipal, industrial)

- WELL COMPLETION DATA:
- (1) diameter (inches) 4
 - (2) total depth (feet) 140
 - (3) static water level (feet) 100 below above top of ground.
 - (4) casing PVC, 132,
 (material) (depth)
4 if telescope see back.
 (size)
 - (5) screen 8, 132
 (length) (depth to top)
4, PVC
 (size) (material)
 - (6) pump 1/2, 10
 (HP) (yield gpm)
Electric
 (type power)
 - (7) electric log no
 (yes or no)
 (organization running log)
 - (8) how well bottom plugged Seal

DRILLERS REMARKS:


DEPT. OF NATURAL RESOURCES
 BUREAU OF LAND & WATER RESOURCES

OCT 18 1982

RECEIVED

If well telescopes please sketch and show depths.

GROUND LEVEL

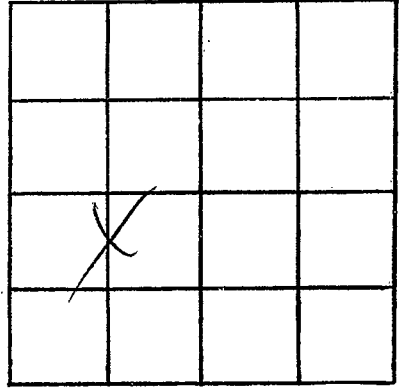

SECTION 10

Please indicate well location X.

ADDITIONAL INFORMATION

If more than one screen,
show locations of each on sketch.