

MISSISSIPPI DEPARTMENT OF NATURAL RESOURCES
 Bureau of Land and Water Resources
 Southport Mall
 P.O. Box 10631
 Jackson, Mississippi 39209
WATER WELL DRILLERS LOG

Pike
M
2045

March 31 19 1983 Pleens Well Service Pike
 date well completed firm name county well located

LANDOWNER:
High Brown
Rt 2 MC Comb
 (mailing address)

description of formations encountered	from to	
<u>clay</u>	<u>0</u>	<u>12</u>
<u>small gravel</u>	<u>12</u>	<u>30</u>
<u>pebbly sand</u>	<u>30</u>	<u>53</u>
<u>solid gravel</u>	<u>53</u>	<u>71</u>

WELL LOCATION:
 sec. 10 T. 1 N. R. 9 E.
3 miles E-NE of Progress
 (distance) (direction) (nearest town)

WELL PURPOSE: house
 (home, irrigation, municipal, industrial)


- WELL COMPLETION DATA:
- (1) diameter (inches) 4"
 - (2) total depth (feet) 71
 - (3) static water level (feet) 32 below top of ground.
 - (4) casing plastic (material) bottom (depth)
 - (5) screen 5' (length) 66" (depth to top)
4" (size) plastic (material)
 - (6) pump Sub (HP) 10 (yield gpm)
electric (type power)
 - (7) electric log no (yes or no)
_____ (organization running log)
 - (8) how well bottom plugged back wash

DRILLERS REMARKS:

DEPT. OF NATURAL RESOURCES
 BUREAU OF LAND & WATER RESOURCES
 JUN 17 1983
RECEIVED

If well telescopes please sketch and show depths.

GROUND LEVEL

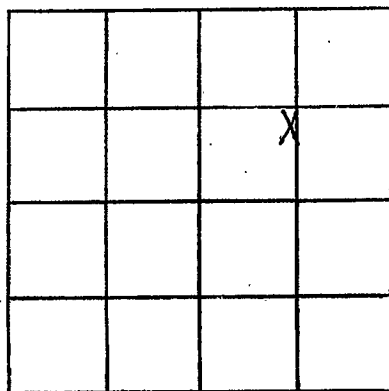

SECTION 10

Please indicate well location X.

ADDITIONAL INFORMATION

If more than one screen,
show locations of each on sketch.