

MISSISSIPPI DEPARTMENT OF NATURAL RESOURCES

Bureau of Land and Water Resources

Southport Mall

P.O. Box 10631

Jackson, Mississippi 39209

WATER WELL DRILLERS LOG

Pike
M
2046

May 19 1983 Rivers Well Dr Pike
 date well completed firm name county well located

LANDOWNER: Walter Sumner
At 2 McComb
 (mailing address)

Description of formations encountered	from	to
<u>Red Clay</u>	<u>0</u>	<u>18</u>
<u>Red Sand</u>	<u>18</u>	<u>60</u>
<u>Sand & gravel</u>	<u>60</u>	<u>95</u>

WELL LOCATION:
 sec. 3 T. 1 N. R. 9 E
3 miles NNE of Proyers
 (distance) (direction) (nearest town)

WELL PURPOSE: Tranite
 (home, irrigation, municipal, industrial)

- WELL COMPLETION DATA:
- (1) diameter (inches) 4 1/2"
 - (2) total depth (feet) 90
 - (3) static water level (feet) 65 below above top of ground.
 - (4) casing plastic bottom
 (material) (depth)
 - (5) screen 5' 85'
 (length) (depth to top)
 - (6) pump 4" plastic
 (size) (material)
 - (7) pump 1/2 10
 (HP) (yield gpm)
 - (8) electric
 (type power)
 - (9) electric log no
 (yes or no)
 - (10) no
 (organization running log)


(8) how well bottom plugged
high wash

DRILLERS REMARKS:
no

DEPT. OF NATURAL RESOURCES
 BUREAU OF LAND & WATER RESOURCES
 JUL 5 1983
RECEIVED

If well telescopes please
sketch and show depths.

GROUND LEVEL

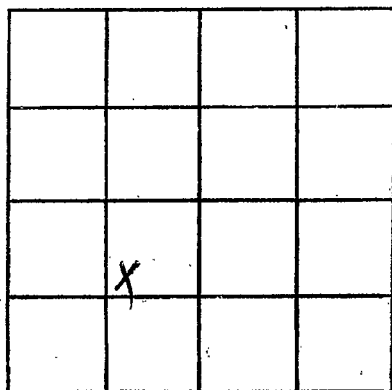

SECTION 3

Please indicate well location X.

ADDITIONAL INFORMATION

If more than one screen,
show locations of each on sketch.