

MISSISSIPPI DEPARTMENT OF NATURAL RESOURCES

Bureau of Land and Water Resources

Southport Mall

P.O. Box 10631

Jackson, Mississippi 39209

WATER WELL DRILLERS LOG

Pike
M
2047

Aug 18 1983 Perryville Pike
 date well completed firm name county well located

LANDOWNER:	description of formations encountered	from	to
<u>George Simmons</u>	<u>Clay</u>	<u>10</u>	<u>16</u>
<u>Rt 2 N. Comb -</u> (mailing address)	<u>Red sand</u>	<u>16</u>	<u>70</u>
WELL LOCATION:	<u>Chalk & gravel</u>	<u>90</u>	<u>95</u>
sec. <u>3</u> T <u>1</u> N R <u>9</u> E	<u>pink chalk</u>	<u>95</u>	<u>108</u>
<u>3</u> miles <u>N-NE</u> of <u>Proctor</u> (distance) (direction) (nearest town)	<u>gravel & sand</u>	<u>108</u>	<u>120</u>
WELL PURPOSE: <u>Trailer</u> (home, irrigation, municipal, industrial)			
WELL COMPLETION DATA:			
(1) diameter (inches) <u>4 1/2"</u>			
(2) total depth (feet) <u>120</u>			
(3) static water level (feet) <u>80</u> below above top of ground.			
(4) casing <u>plastic, bottom</u> (material) (depth)			
_____ If telescope see back. (size)			
(5) screen <u>5'</u> , <u>115'</u> (length) (depth to top)			
<u>4"</u> , <u>plastic</u> (size) (material)			
(6) pump <u>1/2</u> <u>10</u> (HP) (yield gpm)			
<u>split</u> (type power)			
(7) electric log <u>no</u> (yes or no)			
_____ (organization running log)			
(8) how well bottom plugged <u>lock wash</u>			
DRILLERS REMARKS: _____			


DEPT. OF NATURAL RESOURCES
 BUREAU OF LAND & WATER RESOURCES

DEC - 7 1983

RECEIVED

If well telescopes please sketch and show depths.

GROUND LEVEL

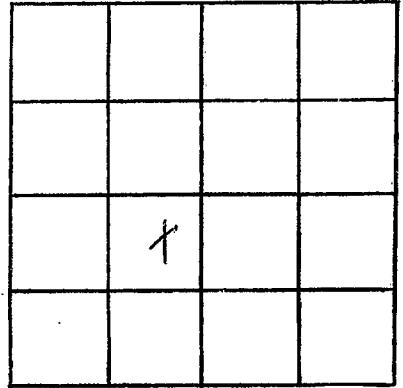

SECTION 3

Please indicate well location X.

ADDITIONAL INFORMATION

If more than one screen,
show locations of each on sketch.