

MISSISSIPPI DEPARTMENT OF NATURAL RESOURCES

Bureau of Land and Water Resources

Southport Mall

P.O. Box 10631

Jackson, Mississippi 39209

WATER WELL DRILLERS LOG

*Pike*  
M 2049

1-21 1984  
date well completed

*F. L. General well Ser*  
firm name

*Pike*  
county well located

LANDOWNER:  
*Billy Ray Simons*  
*R.R. Osypans.*  
(mailing address)

description of formations encountered	from	to
<i>Red clay</i>	<i>0</i>	<i>20</i>
<i>Red sand</i>	<i>20</i>	<i>70</i>
<i>White chalk</i>	<i>70</i>	<i>150</i>
<i>Coarse sand &amp; gravel</i>	<i>150</i>	<i>170</i>

WELL LOCATION:  
sec. *20* T. *1* N. R. *9* E  
S W  
*1/2* miles *S* of *Prager*  
(distance) (direction) (nearest town)

WELL PURPOSE: *Home*  
(home, irrigation, municipal, industrial)

- WELL COMPLETION DATA:
- (1) diameter (inches) *4*
  - (2) total depth (feet) *170*
  - (3) static water level (feet) *95* below above top of ground.
  - (4) casing *PVC, 162*  
(material) (depth)  
*4* if telescope see back.  
(size)
  - (5) screen *8, 162*  
(length) (depth to top)  
*4, PVC*  
(size) (material)
  - (6) pump *1/2, 10*  
(HP) (yield gpm)  
*electric*  
(type power)
  - (7) electric log *no*  
(yes or no)  
*Electric*  
(organization running log)
  - (8) how well bottom plugged *Electric*

DRILLERS REMARKS:


DEPT. OF NATURAL RESOURCES  
BUREAU OF LAND & WATER RESOURCES

MAR - 8 1984

RECEIVED

If well telescopes please  
sketch and show depths.

GROUND LEVEL

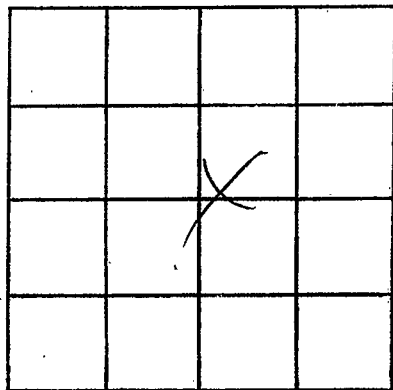

SECTION 20

Please indicate well location X.

ADDITIONAL INFORMATION

If more than one screen,  
show locations of each on sketch.