

<i>Pike</i>
M
2050

MISSISSIPPI DEPARTMENT OF NATURAL RESOURCES
 Bureau of Land and Water Resources
 Southport Mall
 P.O. Box 10631
 Jackson, Mississippi 39209
WATER WELL DRILLERS LOG

3-16 1984 *Fitzgerald* *Pike*
 date well completed firm name county well located

LANDOWNER:	description of formations encountered	from	to
<i>Don Lee</i>			
<i>R.R. Mearns</i> (mailing address)	<i>Red Clay</i>	<i>0</i>	<i>20</i>
	<i>Red Sand</i>	<i>20</i>	<i>80</i>
	<i>Coarse Sand & gravel</i>	<i>80</i>	<i>110</i>
WELL LOCATION:			
sec. <u>6</u> T <u>1</u> N R <u>9</u> E S W			
<u>4</u> miles <u>N</u> of <u>Prosser</u> (distance) (direction) (nearest town)			
WELL PURPOSE: (home, irrigation, municipal, industrial)			
WELL COMPLETION DATA:			
(1) diameter (inches) <u>4</u>			
(2) total depth (feet) <u>110</u>			
(3) static water level (feet) <u>86</u> below top of ground.			
(4) casing <u>PVC</u> , <u>102</u> , (material) (depth)			
<u>4</u> (size) if telescope see back.			
(5) screen <u>8</u> , <u>102</u> (length) (depth to top)			
<u>4</u> , <u>PVC</u> (size) (material)			
(6) pump <u>1/2</u> , <u>10</u> (HP) (yield gpm)			
<u>el</u> (type power)			
(7) electric log <u>no</u> (yes or no)			
(organization running log)			
(8) how well bottom plugged <u>Set the</u>			
DRILLERS REMARKS:			


DEPT. OF NATURAL RESOURCES
 BUREAU OF LAND & WATER RESOURCES

APR 25 1984

RECEIVED

If well telescopes please
sketch and show depths.

GROUND LEVEL

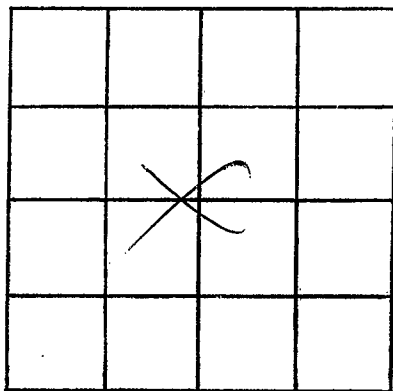

SECTION 6

Please indicate well location X.

ADDITIONAL INFORMATION

If more than one screen,
show locations of each on sketch.