

PIKE
M 2051

MISSISSIPPI DEPARTMENT OF NATURAL RESOURCES
Bureau of Land and Water Resources
Southport Mall
P.O. Box 10631
Jackson, Mississippi 39209
WATER WELL DRILLERS LOG

June 13 1984 Reems Well Service Pike
date well completed firm name county well located

LANDOWNER:
George C. Schilling
Rt 2 McComb
(mailing address)

description of formations encountered	from	to
red clay	0	15
sand & gravel	15	112

WELL LOCATION:
sec 35 T 1 N R 9 E
4 1/2 miles ESE of Progress
(distance) (direction) (nearest town)

WELL PURPOSE: Water
(home, irrigation, municipal, industrial)

- WELL COMPLETION DATA:
- (1) diameter (inches) 4"
 - (2) total depth (feet) 112
 - (3) static water level (feet) 90 ~~above~~ below top of ground.
 - (4) casing plastic, bottom
(material) (depth)
 - If telescope see back.
(size)
 - (5) screen 6', 106'
(length) (depth to top)
 - 4", plastic
(size) (material)
 - (6) pump 1/2 hp, 10
(HP) (yield gpm)
 - plast
(type power)
 - (7) electric log no
(yes or no)
 - (organization running log)
 - (8) How well bottom plugged back wash

DEPT. OF NATURAL RESOURCES
BUREAU OF LAND & WATER RESOURCES


JUL 30 1984

RECEIVED

DRILLERS REMARKS:

If well telescopes please sketch and show depths.

GROUND LEVEL

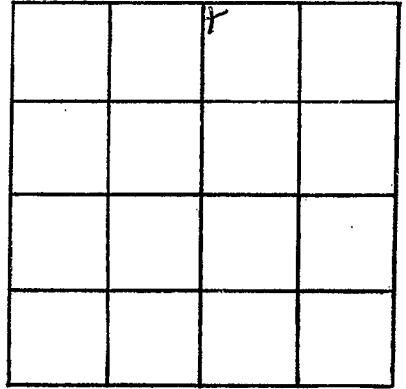

SECTION 35

Please indicate well location X.

ADDITIONAL INFORMATION

If more than one screen,
show locations of each on sketch.