

MISSISSIPPI DEPARTMENT OF NATURAL RESOURCES

Bureau of Land and Water Resources

Southport Mall

P.O. Box 10631

Jackson, Mississippi 39209

WATER WELL DRILLERS LOG

PIKE
M
2052

12-12
date well completed

1984 F. Gould Level Serv
firm name

Pike
county well located


LANDOWNER:	description of formations encountered	from	to
A. Varnado			
R.R. Oyster (mailing address)	Red clay Red sand Coarse sand & gravel	0 20 110	20 110 128
WELL LOCATION:			
sec. 19-T-1-N S R-9-E W			
1 miles W of Progers (distance) (direction) (nearest town)			
WELL PURPOSE: Home (home, irrigation, municipal, industrial)			
WELL COMPLETION DATA:			
(1) diameter (inches) 4			
(2) total depth (feet) 128			
(3) static water level (feet) 90 below top of ground.			
(4) casing PVC, 120 (material), (depth)			
4 (size) if telescope see back.			
(5) screen 8 (length), 120 (depth to top)			
4 (size), PVC (material)			
(6) pump 1/2 (HP), 10 (yield gpm)			
Elec (type power)			
(7) electric log 28 (yes or no)			
(organization running log)			
(8) how well bottom plugged Sand Shuk			

Red 1-785
28

DRILLERS REMARKS:

If well telescopes please sketch and show depths.

GROUND LEVEL

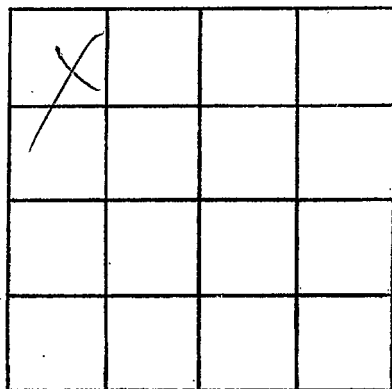

SECTION 19

Please indicate well location X.

ADDITIONAL INFORMATION

If more than one screen,
show locations of each on sketch.