

**MISSISSIPPI DEPARTMENT OF NATURAL RESOURCES**  
 Bureau of Land and Water Resources  
 Southport Mall  
 P.O. Box 10631  
 Jackson, Mississippi 39209  
**WATER WELL DRILLERS LOG**

M 2053  
PIKE  
9-27-85

9-27

1985

Stafford Wilson Wellbore P. Ke

date well completed

firm name

county well located

LANDOWNER: William G. Stortevy  
Rt. 2  
McComb, Ms. 39648  
 (mailing address)

WELL LOCATION:  
 sec. 31 T. 1N R. 9E  
2 1/2 miles SE of Progress  
 (distance) (direction) (nearest town)

WELL PURPOSE: home  
 (home, irrigation, municipal, industrial)

- WELL COMPLETION DATA:
- diameter (inches) 4"
  - total depth (feet) 178'
  - static water level (feet) 73' below top of ground. above
  - casing plastic, 129'  
 (material) (depth)  
 (size) if telescope see back.
  - screen 10', 118'  
 (length) (depth to top)  
4", plastic  
 (size) (material)
  - pump 1/2, 11  
 (HP) (yield gpm)  
electric  
 (type power)
  - electric log (yes or no) \_\_\_\_\_  
 (organization running log) \_\_\_\_\_
  - how well bottom plugged small SHARK

description of formations encountered	from	to
<u>top soil</u>	<u>0</u>	<u>6"</u>
<u>red clay</u>	<u>6"</u>	<u>17'</u>
<u>red clay &amp; gravel</u>	<u>17'</u>	<u>24'</u>
<u>fine sand</u>	<u>24'</u>	<u>50'</u>
<u>course sand</u>	<u>50'</u>	<u>70'</u>
<u>red chalk</u>	<u>70'</u>	<u>90'</u>
<u>course sand &amp; gravel</u>	<u>90'</u>	<u>178'</u>


**RECEIVED**  
 OCT - 1 1985

Department of Natural Resources  
 Bureau of Land & Water Resources

DRILLERS REMARKS:  
Well bore empty  
by Esley Staffed

If well telescopes please sketch and show depths.

GROUND LEVEL

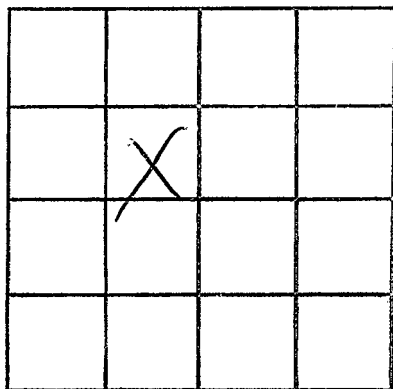

SECTION 21

Please indicate well location X.

ADDITIONAL INFORMATION

If more than one screen,  
show locations of each on sketch.