

MISSISSIPPI DEPARTMENT OF NATURAL RESOURCES

Bureau of Land and Water Resources

Southport Mall

P.O. Box 10631

Jackson, Mississippi 39209

WATER WELL DRILLERS LOG

PIKE
M
2054

1-7
date well completed

1986 Fitzgerald well drill
firm name

Pike
county well located

LANDOWNER:	description of formations encountered	from	to
Sula Tate			
R.R. Magnolia (mailing address)	Red clay Red Sand Coarse Sand & gravel	0 20 80	20 80 95
WELL LOCATION:			
sec. 18 T 1 N R 9 E S W			
1 1/2 miles NW of Progress (distance) (direction) (nearest town)			
WELL PURPOSE: Home (home, irrigation, municipal, industrial)			
WELL COMPLETION DATA:			
(1) diameter (inches) 4			
(2) total depth (feet) 95			
(3) static water level (feet) 50 below top of ground.			
(4) casing PVC 85 (material) (depth)			
4 (size) if telescope see back.			
(5) screen 10 85 (length) (depth to top)			
4 PVC (size) (material)			
(6) pump 1/2 10 (HP) (yield gpm)			
Electric (type power)			
(7) electric log No (yes or no)			
(organization running log)			
(8) how well bottom plugged			


RECEIVED
JAN 30 1986

Department of Natural Resources
Bureau of Land & Water Resources

DRILLERS REMARKS:

If well telescopes please sketch and show depths.

GROUND LEVEL

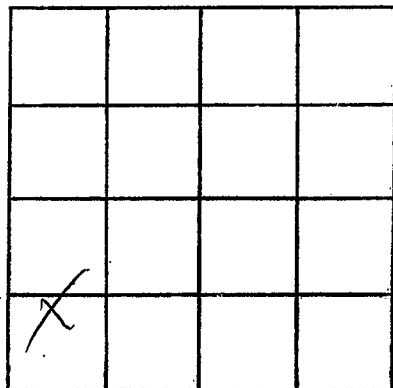

SECTION 18

Please indicate well location X.

ADDITIONAL INFORMATION

If more than one screen,
show locations of each on sketch.