

MISSISSIPPI DEPARTMENT OF NATURAL RESOURCES

Bureau of Land and Water Resources

Southport Mall

P.O. Box 10631

Jackson, Mississippi 39209

WATER WELL DRILLERS LOG

PIKE
M
2055

3-4
date well completed

1986 Fitzwellwell
firm name

Pike
county well located

LANDOWNER:

Carolyn Wrautay

R.R. 2, McComb, Ms.
(mailing address)

description of formations encountered

from

to

Red clay	0	20
fine sand	20	90
white chalk	90	132
Coarse sand & gravel	132	145

WELL LOCATION:


sec. 20 T 1 N R 9 E
S W
1/2 miles S of Progress
(distance) (direction) (nearest town)

WELL PURPOSE:

Home
(home, irrigation, municipal, industrial)

WELL COMPLETION DATA:

- diameter (inches) 4
- total depth (feet) 145
- static water level (feet) 70 below above top of ground.
- casing PVC, 135,
(material) (depth)
4 if telescope see back.
(size)
- screen 10, 135
(length) (depth to top)
4, PVC
(size) (material)
- pump 1/2, 10
(HP) (yield gpm)
elec
(type power)
- electric log No
(yes or no)
(organization running log)
- how well bottom plugged Sealed

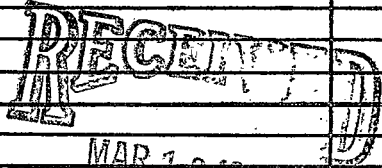


MAR 17 1986

Department of Natural Resources
Bureau of Land & Water Resources

DRILLERS REMARKS:

If well telescopes please sketch and show depths.

GROUND LEVEL

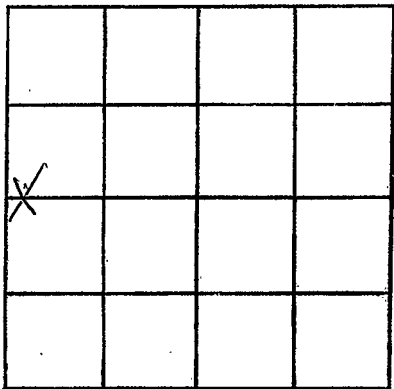

SECTION 20

Please indicate well location X.

ADDITIONAL INFORMATION

If more than one screen, show locations of each on sketch.