

MISSISSIPPI DEPARTMENT OF NATURAL RESOURCES

Bureau of Land and Water Resources

Southport Mall

P.O. Box 10631

Jackson, Mississippi 39209

WATER WELL DRILLERS LOG

PIKE
M
2051

4-3 1986 Steffens Water Well Pike
date well completed firm name county well located

LANDOWNER:	description of formations encountered	from	to
<u>Michael Donawa</u>			
<u>Rt. 2 Box 150-R</u>	<u>Top Soil</u>	<u>0</u>	<u>1'</u>
<u>McComb, Ms. 39648</u> (mailing address)	<u>SAND</u>	<u>1'</u>	<u>3'</u>
WELL LOCATION:	<u>red clay</u>	<u>3'</u>	<u>27'</u>
sec. <u>19</u> T. <u>1</u> S. R. <u>9</u> E.	<u>red clay + gravel</u>	<u>27'</u>	<u>70'</u>
<u>11</u> miles <u>NW</u> of <u>Magnolia</u> (distance) (direction) (nearest town)	<u>POURSE SAND</u>	<u>70'</u>	<u>95'</u>
WELL PURPOSE: <u>None</u> (home, irrigation, municipal, industrial)	<u>pink clay</u>	<u>95'</u>	<u>123'</u>
WELL COMPLETION DATA:	<u>POURSE SAND + GRAVEL</u>	<u>123'</u>	<u>150'</u>
(1) diameter (inches) <u>4"</u>			
(2) total depth (feet) <u>150'</u>			
(3) static water level (feet) <u>90'</u> ^{below} top of ground.			
(4) casing <u>plastic</u> , <u>150'</u> (material) (depth)			
(size) If telescope see back.			
(5) screen <u>10'</u> , <u>140'</u> (length) (depth to top)			
<u>4"</u> , <u>plastic</u> (size) (material)			
(6) pump <u>1/2</u> , <u>11</u> (HP) (yield gpm)			
<u>electric</u> (type power)			
(7) electric log _____ (yes or no)			
_____ (organization running log)			
(8) how well bottom plugged <u>STANDARD</u>			



MAY 01 1986


Department of Natural Resources
Bureau of Land & Water Resources

DRILLERS REMARKS:

Bill Blum

If well telescopes please sketch and show depths.

GROUND LEVEL

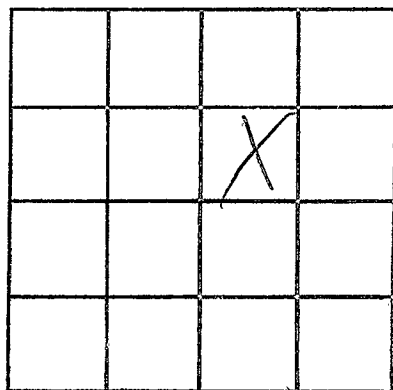

SECTION 19

Please indicate well location X.

ADDITIONAL INFORMATION

If more than one screen,
show locations of each on sketch.