

MISSISSIPPI DEPARTMENT OF NATURAL RESOURCES

Bureau of Land and Water Resources

Southport Mall

P.O. Box 10631

Jackson, Mississippi 39209

WATER WELL DRILLERS LOG

PIKE
M
2058

4-7

19

86 Stafford Water Well

Pike

date well completed

firm name

county well located

LANDOWNER: Paul Bernes

Rt. 1 Box 533

Osyka, MS. 39654
(mailing address)

WELL LOCATION:

sec. 34 T. 1 N. R. 9 E. S. 4 W.
15 miles EAST of OSYKA
(distance) (direction) (nearest town)

WELL PURPOSE: DOMESTIC
(home, irrigation, municipal, industrial)

WELL COMPLETION DATA:

- (1) diameter (inches) 4"
- (2) total depth (feet) 140'
- (3) static water level (feet) 85 below above top of ground.
- (4) casing plastic, 140' (material) (depth)
(size) If telescope see back.
- (5) screen 10' 130' (length) (depth to top)
4" plastic (size) (material)
- (6) pump 1/2 11 (HP) (yield gpm)
electric (type power)
- (7) electric log (yes or no)
(organization running log)

(8) how well bottom plugged

SAND-SAND

DRILLERS REMARKS:


John Bernes

description of formations encountered

from

to

top soil	0	6"
red sand	6"	15'
red clay	15'	45'
red sand + peagravel	45'	54'
pink clay	54'	65'
course sand	65'	90'
red clay	90'	95'
course sand + gravel	95'	140'

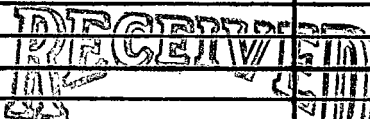


MAY 21 1966

Department of Natural Resources
Bureau of Land and Water Resources

If well telescopes please sketch and show depths.

GROUND LEVEL

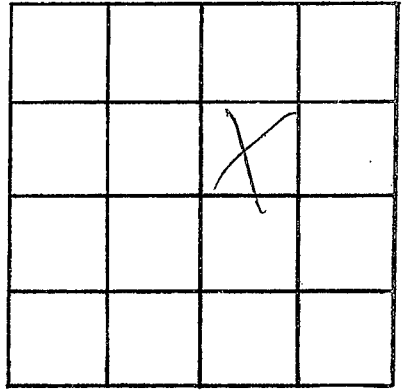

SECTION 34

Please indicate well location X.

ADDITIONAL INFORMATION

If more than one screen,
show locations of each on sketch.