

MISSISSIPPI DEPARTMENT OF NATURAL RESOURCES
 Bureau of Land and Water Resources
 Southport Mall
 P.O. Box 10631
 Jackson, Mississippi 39209
WATER WELL DRILLERS LOG

Pike
M
2059

5-7 1986 Fitzgerald Well Serv Pike
 date well completed firm name county well located

LANDOWNER:
Johnny Beason
Rh. E. McComb, Jr.
 (mailing address)


description of formations encountered	from	to
	<u>Red clay</u>	<u>0</u>
<u>Red sand</u>	<u>20</u>	<u>108</u>
<u>Coarse sand & gravel</u>	<u>108</u>	<u>121</u>

WELL LOCATION:
 sec. 8 T. 1 N. R. 9 E
 S W
3 miles NE of Prezons
 (distance) (direction) (nearest town)

WELL PURPOSE: Home
 (home, irrigation, municipal, industrial)


- WELL COMPLETION DATA:**
- diameter (inches) 4
 - total depth (feet) 121
 - static water level (feet) 25 below above top of ground.
 - casing PVC, 111,
 (material) (depth)
4 if telescope see back.
 (size)
 - screen 10, 111
 (length) (depth to top)
4, PVC
 (size) (material)
 - pump 1 20
 (HP) (yield gpm)
elec
 (type power)
 - electric log No
 (yes or no)
 (organization running log)
 - how well bottom plugged Seal blk

DRILLERS REMARKS:

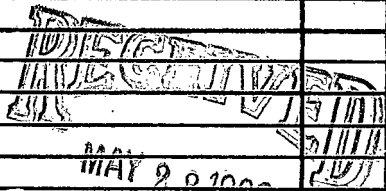
 MAY 28 1986
 Department of Natural Resources
 Bureau of Land & Water Resources

If well telescopes please sketch and show depths.

GROUND LEVEL

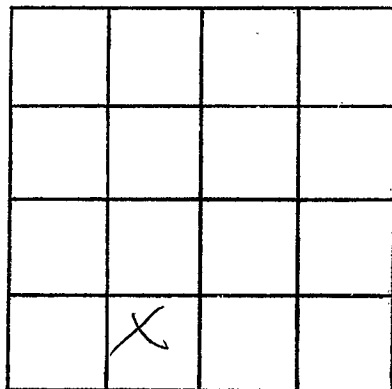

SECTION 8

Please indicate well location X.

ADDITIONAL INFORMATION

If more than one screen,
show locations of each on sketch.