

MISSISSIPPI DEPARTMENT OF NATURAL RESOURCES

Bureau of Land and Water Resources

Southport Mall

P.O. Box 10631

Jackson, Mississippi 39209

WATER WELL DRILLERS LOG

PIKE
M
2061

7-8-84

19 Stafford Water Well

Pike

date well completed

firm name

county well located

LANDOWNER: Jack Simmons

description of formations encountered

from to

Rt. 2

Osyka, MS 39654
(mailing address)

Top Soil

0 1'

WELL LOCATION:

DRUGN CLAY

1' 6'

sec. 34 T. 1 N. 9 E

Red clay gravel

6' 56'

14 miles South of Magnolia
(distance) (direction) (nearest town)

Red clay

56' 63'

WELL PURPOSE: None
(home, irrigation, municipal, industrial)

ROCK & SAND

63' 94'

WELL COMPLETION DATA:

- (1) diameter (inches) 4"
- (2) total depth (feet) 94'
- (3) static water level (feet) 72 ^{below} above top of ground.

- (4) casing plastic, 94'
(material) (depth)

(size) if telescope see back.

- (5) screen 10', 84'
(length) (depth to top)

4", plastic
(size) (material)

- (6) pump 1/2, 11
(HP) (yield.gpm)


electric
(type power)

- (7) electric log
(yes or no)

(organization running log)

- (8) how well bottom plugged sand
shank

DRILLERS REMARKS:

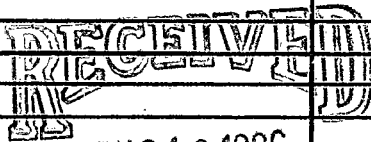


AUG 12 1986

Department of Natural Resources
Bureau of Land & Water Resources

If well telescopes please sketch and show depths.

GROUND LEVEL

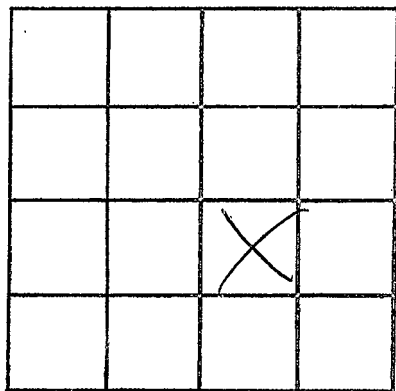

SECTION 34

Please indicate well location X.

ADDITIONAL INFORMATION

If more than one screen,
show locations of each on sketch.