

MISSISSIPPI DEPARTMENT OF NATURAL RESOURCES

Bureau of Land and Water Resources

Southport Mall

P.O. Box 10631

Jackson, Mississippi 39209

WATER WELL DRILLERS LOG

PIKE
MA

9-3-

1986

Stafford State Well

Pike

date well completed

firm name

county well located

LANDOWNER: William A. Fatten
P.O. Box 256
Summit, MS 39666
(mailing address)

WELL LOCATION:
sec. 7 T. 1 N. R. 9 E
11 miles SW of Magnolia
(distance) (direction) (nearest town)

WELL PURPOSE: none
(home, irrigation, municipal, industrial)

WELL COMPLETION DATA:

(1) diameter (inches) 4"

(2) total depth (feet) 125'

(3) static water level (feet) 87 ^{below} above top of ground.

(4) casing plastic, 125'
(material) (depth)
(size) if telescope see back.

(5) screen 10', 115'
(length) (depth to top)
4", plastic
(size) (material)

(6) pump 1/2, 11
(HP) (yield gpm)
electric
(type power)

(7) electric log yes or no
(organization running log)

(8) how well bottom plugged hard pack

Description of formations encountered	from	to
TOP SOIL	0	6"
brown clay	6"	4'
Red clay gravel	4'	30'
pink clay	30'	42'
SAND + gravel	42'	96'
Red clay	96'	103'
SAND + gravel	103'	125'

RECEIVED


OCT 07 1986

Department of Natural Resources
Bureau of Land & Water Resources

DRILLERS REMARKS:

If well telescopes please sketch and show depths.

GROUND LEVEL

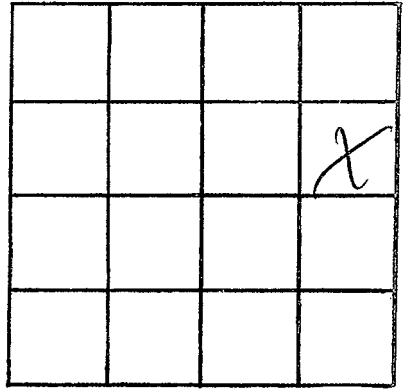

SECTION 9

Please indicate well location X.

ADDITIONAL INFORMATION

If more than one screen,
show locations of each on sketch.