

MISSISSIPPI DEPARTMENT OF NATURAL RESOURCES

Bureau of Land and Water Resources

Southport Mall

P.O. Box 10631


Jackson, Mississippi 39209

WATER WELL DRILLERS LOG

PIKE
M 2063

Nov 2 19 86 Stephens Well Pike
 date well completed firm name county well located

LANDOWNER:	description of formations encountered	from	to
<u>Bl 2</u>	<u>top soil</u>	<u>0</u>	<u>2'</u>
<u>McComb, Ms. 39648</u> (mailing address)	<u>brown clay</u>	<u>1'</u>	<u>12'</u>
WELL LOCATION: sec. <u>10</u> T <u>1</u> N R <u>9</u> E S W <u>15</u> miles <u>West NW</u> of <u>Magnolia</u> (distance) (direction) (nearest town)	<u>Red clay</u>	<u>12'</u>	<u>80'</u>
WELL PURPOSE: <u>home</u> (home, irrigation, municipal, industrial)	<u>100% sand & gravel</u>	<u>88'</u>	<u>135'</u>
WELL COMPLETION DATA: (1) diameter (inches) <u>4"</u> (2) total depth (feet) <u>135'</u> (3) static water level (feet) <u>92</u> <u>below</u> above top of ground. (4) casing <u>plastic</u> , <u>135'</u> (material) (depth) _____ if telescope see back. (size) (5) screen <u>10'</u> , <u>125'</u> (length) (depth to top) <u>4"</u> , <u>plastic</u> (size) (material) (6) pump <u>1</u> , <u>23</u> (HP) (yield gpm) <u>electric</u> (type power) (7) electric log _____ (yes or no) _____ (organization running log) (8) how well bottom plugged: <u>SAND SHARK</u>			
DRILLERS REMARKS:			

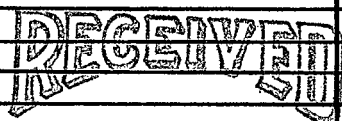


NOV 12 1986

Department of Natural Resources
Bureau of Land & Water Resources

If well telescopes please sketch and show depths.

GROUND LEVEL

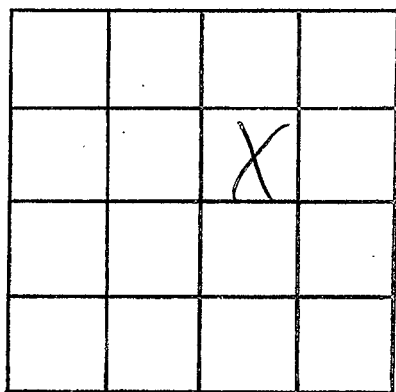

SECTION 10

Please indicate well location X.

ADDITIONAL INFORMATION

If more than one screen,
show locations of each on sketch.