

Pike
M 2064

MISSISSIPPI DEPARTMENT OF NATURAL RESOURCES
 Bureau of Land and Water Resources
 Southport Mall
 P.O. Box 10631
 Jackson, Mississippi 39209
WATER WELL DRILLERS LOG

Nov 18 1986 - Fitzgerald well serv Pike -
 date well completed firm name county well located

LANDOWNER:	description of formations encountered	from	to
<u>Golden Simmons</u>			
<u>R.B. 2 MC Comb, m 5</u> (mailing address)	<u>Red clay -</u> <u>Red sand</u> <u>Coarse sand & gravel</u>	<u>0</u> <u>20</u> <u>120</u>	<u>20</u> <u>120</u> <u>133</u>
WELL LOCATION:			
sec. <u>11</u> T. <u>1</u> N. S. R. <u>9</u> E. W.			
<u>4</u> miles <u>S</u> of <u>Pikes Cross</u> (distance) (direction) (nearest town)			
WELL PURPOSE: <u>Home</u> (home, irrigation, municipal, industrial)			
WELL COMPLETION DATA:			
(1) diameter (inches) <u>4</u>			
(2) total depth (feet) <u>133</u>			
(3) static water level (feet) <u>57</u> below above top of ground.			
(4) casing <u>PVC</u> <u>123</u> (material) (depth)			
<u>4</u> if telescope see back. (size)			
(5) screen <u>10</u> <u>123</u> (length) (depth to top)			
<u>4</u> <u>PVC</u> (size) (material)			
(6) pump <u>1/2</u> <u>10</u> (HP) (yield gpm)			
<u>Electric</u> (type power)			
(7) electric log <u>no</u> (yes or no)			
(organization running log)			
(8) how well bottom plugged <u>fully</u>			

RECEIVED


DEC 22 1986

Department of Natural Resources
 Bureau of Land & Water Resources

DRILLERS REMARKS:

If well telescopes please sketch and show depths.

GROUND LEVEL

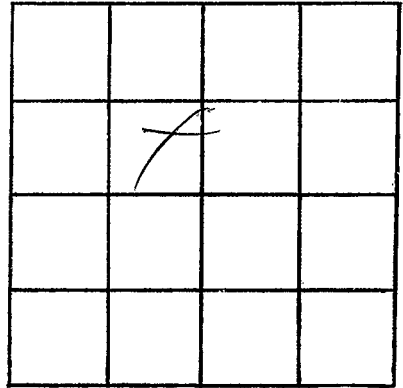

SECTION 11

Please indicate well location X.

ADDITIONAL INFORMATION

If more than one screen,
show locations of each on sketch.