

MISSISSIPPI DEPARTMENT OF NATURAL RESOURCES

Bureau of Land and Water Resources

Southport Mall

P.O. Box 10631

Jackson, Mississippi 39209

WATER WELL DRILLERS LOG

PIKE
M 2005

12-26 1986
date well completed

F. Howell well dr
firm name

Pike
county well located

LANDOWNER:	description of formations encountered	from	to
<i>Michael Zetaran</i> <i>R.R. Lightowers</i> (mailing address)			
WELL LOCATION: sec. <i>12</i> T <i>1</i> N S R <i>9</i> E W <i>2</i> miles <i>S</i> of <i>DYKES CROSS</i> (distance) (direction) (nearest town)			
WELL PURPOSE: <i>Home</i> (home, irrigation, municipal, industrial)			
WELL COMPLETION DATA: (1) diameter (inches) <i>4</i> (2) total depth (feet) <i>115</i> (3) static water level (feet) <i>42</i> below above top of ground. (4) casing <i>PVC</i> , <i>105</i> (material) (depth) <i>4</i> (size) if telescope see back. (5) screen <i>10</i> , <i>105</i> (length) (depth to top) <i>4</i> , <i>PVC</i> (size) (material) (6) pump <i>1/2</i> , <i>10</i> (HP) (yield gpm) <i>Electric</i> (type power) (7) electric log <i>no</i> (yes or no) (organization running log) (8) how well bottom plugged <i>See log</i>			
DRILLERS REMARKS:			


RECEIVED

FEB 12 1987

Department of Natural Resources
Bureau of Land & Water Resources

If well telescopes please sketch and show depths.

GROUND LEVEL

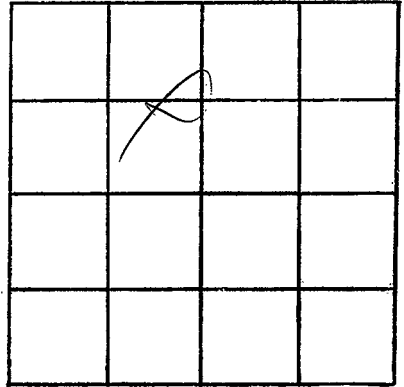

SECTION 12

Please indicate well location X.

ADDITIONAL INFORMATION

If more than one screen,
show locations of each on sketch.