

MISSISSIPPI DEPARTMENT OF ENVIRONMENTAL QUALITY

Office of Land and Water Resources

P. O. Box 10631
Jackson, MS 39289-0631
WATER WELL DRILLERS LOG

COUNTY WELL LOCATED	
WELL NUMBER <i>2084</i>	CODED
DATE WELL COMPLETED <i>June 17 93</i>	

PERMIT NUMBER
NAME OF DRILLING FIRM <i>F. T. LGERARD Well Serv</i>

NAME & MAILING ADDRESS OF LANDOWNER <i>HOLLIS ALFORD</i> <i>P.R. Orange ms.</i>		
WELL LOCATION: SEC	TOWNSHIP	RANGE
<i>17</i>	<i>1</i>	<i>9</i>
	<i>N</i>	<i>E</i>
	<i>S</i>	<i>W</i>
DISTANCE	DIRECTION	NEAREST TOWN
<i>1/2</i> Miles	<i>E</i>	<i>Orange</i>
OTHER LANDMARK		
WELL PURPOSE: Home, Irrigation, Municipal, Industrial, Fish Pond, etc. <i>DAIRY</i>		

PUMP DATA		
PUMP TYPE (Circle One): Submersible, Turbine, Jet, Flowing Well, Other (Describe)		
POWER TYPE (Circle One): Electric, Tractor, Diesel, Gasoline, Butane, Other (Describe) <i>H/P</i>		
Pump Capacity (GPM) <i>20</i>	No. of Stages <i>10</i>	Setting Depth <i>120</i> FT.
PUMP TEST		
Well yielded <i>50</i> GPM with a drawdown of <i>2</i> ft. after <i>1</i> hours of pumping		

WELL DATA		
Well Depth <i>140</i>	Casing Diameter (In.) <i>4</i>	Casing Length (Ft.) <i>130</i>
Type of Casing <i>PIC</i>	Hole Depth <i>140</i>	Depth to Static Water Level <i>79</i>
TYPE OF COMPLETION: (Circle One or More): <input checked="" type="checkbox"/> Gravel Packed, <input type="checkbox"/> Underreamed, <input type="checkbox"/> Telescoped, <input type="checkbox"/> Natural Development, <input type="checkbox"/> Open Hole, <input type="checkbox"/> Other (Describe)		

LOG DATA	
TYPE OF LOG RUN (Circle One): Electric, Gamma Ray, Density, Sonic, <input checked="" type="checkbox"/> No Log Run, Neutron, Other (Describe)	
Name of Organization Running Log	

WELL GROUTED TO A DEPTH OF <i>10</i> FEET
Type Grout (circle one): Cement, Bentonite, <input checked="" type="checkbox"/> or Mix

GEOLOGIC DATA (Office Use Only)			
Surface Elev.	Geologic Unit	Unit Thickness	Depth to Top
Subs. SWL	Date	Analysis	Aquifer Test

SCREEN DATA		
Diameter - Inches <i>4</i>	Length - Feet <i>10</i>	Slot Size - Inches <i>10/14</i>
Screen Type <i>PIC</i>	Depth to Bottom - Feet <i>140</i>	


Driller's Remarks

DESCRIPTION OF FORMATIONS ENCOUNTERED	FROM	TO
<i>Red clay</i>	<i>0</i>	<i>20</i>
<i>Red sand</i>	<i>20</i>	<i>95</i>
<i>Coarse sand</i>	<i>95</i>	<i>105</i>
<i>Fine sand - clay streaks</i>	<i>105</i>	<i>125</i>
<i>Coarse sand & gravel</i>	<i>125</i>	<i>140</i>

FORMATIONS (Continued)	FROM	TO
RECEIVED		
JUN 29 1993		
Dept. of Environmental Quality Office of Land & Water Resources		
IF MORE SPACE IS NEEDED, USE BACK		

If well telescopes please
sketch and show depths.

GROUND LEVEL

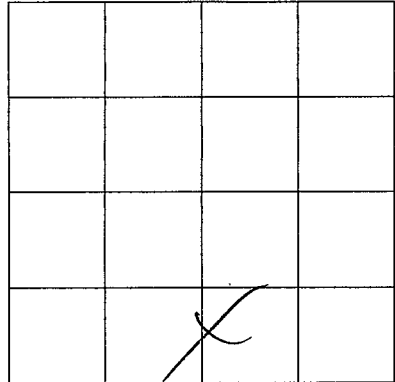

SECTION 17

Please indicate well location X.

ADDITIONAL INFORMATION

If more than one screen,
show location of each on sketch.