

PIKE
M
2086

MISSISSIPPI
BOARD OF WATER COMMISSIONERS
416 North State Street
Jackson, Mississippi 39201

WATER WELL DRILLERS LOG

APR 27 19 94 F. F. GERALD well serv. P. K. county well located
date well completed firm name

LANDOWNER:
Leroy Bumpfield
RR-1 Magnolia ms -
(mailing address)

description of formations encountered	from	to
Red Clay	2	15
Red Sand	15	103
Coarse Sand & gravel	103	120

WELL LOCATION:
sec. 14 T 1 N R 9 E
S W
7 miles W of Lake's
(distance) (direction) (nearest town)

WELL PURPOSE: Home
(home, irrigation, municipal, industrial)

- WELL COMPLETION DATA:
- (1) diameter (inches) 4
 - (2) total depth (feet) 120
 - (3) static water level (feet) 89 below top of ground.
 - (4) casing PVC 110 (material) (depth)
4 (size) if telescope see back.
 - (5) screen 10 110 (length) (depth to top)
4 (size) PVC (material)
 - (6) pump 3/4 10 (HP) (yield gpm)
Elex (type power)
 - (7) electric log No (yes or no)
(organization running log)
 - (8) how well bottom plugged Sand/Slat

RECEIVED


JUN 17 1994

Dept. of Environmental Quality
Office of Land & Water Resources

DRILLERS REMARKS:

If well telescopes please sketch and show depths.

GROUND LEVEL

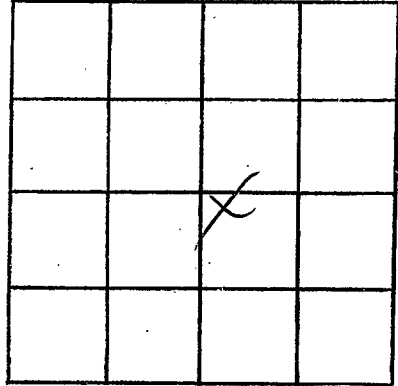

SECTION 14

Please indicate well location X.

ADDITIONAL INFORMATION

If more than one screen,
show locations of each on sketch.