

PIKE
M 2087

MISSISSIPPI
BOARD OF WATER COMMISSIONERS
416 North State Street
Jackson, Mississippi 39201

WATER WELL DRILLERS LOG

MAR 24 1994 Ed GERRARD Well Service Pike
date well completed firm name county well located

LANDOWNER:
NOLA MAE BUCKLEY
R.R. OSYRA, MS.
(mailing address)

description of formations encountered	from	to
<u>Red clay</u>	<u>0</u>	<u>20</u>
<u>Red sand</u>	<u>20</u>	<u>91</u>
<u>Coarse sand & gravel</u>	<u>91</u>	<u>105</u>

WELL LOCATION:
sec. 30 T. 1 N R. 9 E
S W
7 miles E of OSYRA
(distance) (direction) (nearest town)

WELL PURPOSE: Domestic
(home, irrigation, municipal, industrial)

- WELL COMPLETION DATA:
- (1) diameter (inches) 4
 - (2) total depth (feet) 105
 - (3) static water level (feet) 67 below above top of ground.
 - (4) casing PVC, 95,
(material) (depth)
4 if telescope see back.
(size)
 - (5) screen 10, 90
(length) (depth to top)
4, PVC
(size) (material)
 - (6) pump 1/2, 10
(HP) (yield gpm)
Electric
(type power)
 - (7) electric log No
(yes or no)
(organization running log)
 - (8) how well bottom plugged Sealed

RECEIVED


JUN 17 1994

Dept. of Environmental Quality
Office of Land & Water Resources

DRILLERS REMARKS:

If well telescopes please
sketch and show depths.

GROUND LEVEL

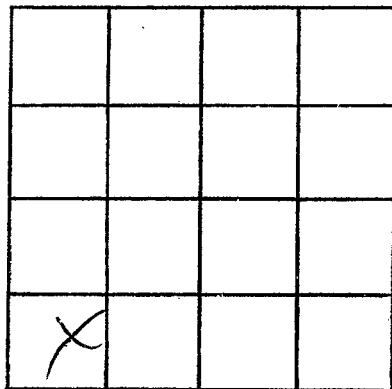

SECTION 30

Please indicate well location X.

ADDITIONAL INFORMATION

If more than one screen,
show locations of each on sketch.