

**MISSISSIPPI DEPARTMENT OF ENVIRONMENTAL QUALITY**  
Bureau of Land and Water Resources

P. O. Box 10631  
Jackson, MS 39289-0631  
**WATER WELL DRILLERS LOG**

COUNTY WELL LOCATED <i>Pike</i>	
WELL NUMBER <i>M</i>	CODED
DATE WELL COMPLETED <i>2095</i> <i>7/6/95</i>	

PERMIT NUMBER <i>0-508</i>
NAME OF DRILLING FIRM <i>Jordan Well Ser.</i>

NAME & MAILING ADDRESS OF LANDOWNER <i>Copeland &amp; Sons Inc.</i>			
<i>Packing Plant</i>			
<i>Osycle, Miss.</i>			
WELL LOCATION: SEC	TOWNSHIP	RANGE	
<i>1</i>	<i>1</i>	<i>N 9 E</i>	<i>W</i>
DISTANCE <i>6</i> Miles	DIRECTION <i>S/W</i>	NEAREST TOWN <i>of Tupertown</i>	
OTHER LANDMARK			
WELL PURPOSE: Home, Irrigation, Municipal, Industrial, Fish Pond, etc. <i>Packing Plant</i>			

<b>PUMP DATA</b>		
PUMP TYPE (Circle One): <input checked="" type="radio"/> Submersible, Turbine, Jet, Flowing Well, Other (Describe) _____		
POWER TYPE (Circle One): <input checked="" type="radio"/> Electric, Tractor, Diesel, Gasoline, Butane, Other (Describe) <i>7</i> H/P <i>1</i>		
Pump Capacity (GPM) <i>20</i>	No. of Stages <i>9</i>	Setting Depth <i>110</i> FT.
PUMP TEST		
Well yielded _____ GPM with a drawdown of _____ ft. after _____ hours of pumping		

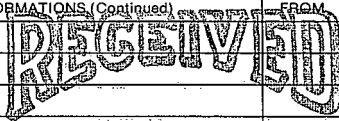
<b>WELL DATA</b>		
Well Depth <i>120</i>	Casing Diameter (In.) <i>4</i>	Casing Length (Ft.) <i>110</i>
Type of Casing <i>PVC</i>	Hole Depth <i>120</i>	Depth to Static Water Level <i>80</i>
TYPE OF COMPLETION: (Circle One or More): Gravel Packed, Underreamed, Telescoped, Natural Development, Open Hole, Other (Describe) <i>10% cement Grout</i>		
Top of Lap Pipe or Reduction in Casing  FEET IF TELESCOPED OR MORE THAN ONE SCREEN: USE BACK PAGE		

<b>LOG DATA</b>	
TYPE OF LOG RUN (Circle One): No Log Run, Electric, Gamma Ray, Density, Sonic, Neutron, Other (Describe) _____	
Name of Organization Running Log	

<b>SCREEN DATA</b>		
Diameter - Inches <i>4</i>	Length - Feet <i>10</i>	Slot Size - Inches <i>1/12</i>
Screen Type <i>PVC</i>	Depth to Bottom - Feet <i>110</i>	

<b>GEOLOGIC DATA (Office Use Only)</b>			
Surface Elev.	Geologic Unit	Unit Thickness	Depth to Top
Subs. SWL	Date	Analysis	Aquifer Test

Driller's Remarks

DESCRIPTION OF FORMATIONS ENCOUNTERED	FROM	TO	FORMATIONS (Continued)	FROM	TO
<i>Top Soil</i>	<i>0</i>	<i>1</i>	 <b>JUL 12 1995</b> Dept. of Environmental Quality Office of Land & Water Resources		
<i>Clay Gravel</i>	<i>1</i>	<i>45</i>			
<i>Gravel</i>	<i>45</i>	<i>80</i>			
<i>Sand</i>	<i>80</i>	<i>120</i>			
IF MORE SPACE IS NEEDED, USE BACK					

If well telescopes please  
sketch and show depths.

GROUND LEVEL

			X

SECTION 1

Please indicate well location X.

ADDITIONAL INFORMATION

If more than one screen,  
show location of each on sketch.