

MISSISSIPPI DEPARTMENT OF ENVIRONMENTAL QUALITY

Office of Land and Water Resources

P. O. Box 10631
Jackson, MS 39289-0631
WATER WELL DRILLERS LOG

COUNTY WELL LOCATED <u>Pike</u>	
WELL NUMBER <u>M</u>	CODED
DATE WELL COMPLETED <u>2094</u> <u>May 13/95</u>	

PERMIT NUMBER
NAME OF DRILLING FIRM <u>F. TIGER AND Well Serv</u>

NAME & MAILING ADDRESS OF LANDOWNER <u>Larry Roberts</u> <u>RR - Osyka, ms</u>			
WELL LOCATION: .SEC	TOWNSHIP	RANGE	
<u>19</u>	<u>1</u>	<u>9</u>	<u>N S E W</u>
DISTANCE	DIRECTION	NEAREST TOWN	
<u>2</u> Miles	<u>4</u>	of <u>Phloxess</u>	
OTHER LANDMARK			
WELL PURPOSE: <u>Home Irrigation</u> , Municipal, Industrial, Fish Pond, etc.			

PUMP DATA			
PUMP TYPE (Circle One): <u>Submersible</u> , Turbine, Jet, Flowing Well, Other (Describe) _____			
POWER TYPE (Circle One): <u>Electric</u> , Tractor, Diesel, Gasoline, Butane, Other (Describe) _____ H/P <u>1/2</u>			
Pump Capacity (GPM)	No. of Stages	Setting Depth	
<u>10</u>	<u>8</u>	<u>95</u>	FT.
PUMP TEST			
Well yielded <u>25</u> GPM with a drawdown of <u>1</u> ft. after <u>2</u> hours of pumping			

WELL DATA		
Well Depth <u>120</u>	Casing Diameter (In.) <u>4</u>	Casing Length (Ft.) <u>110</u>
Type of Casing <u>PVC</u>	Hole Depth <u>120</u>	Depth to Static Water Level <u>65</u>

LOG DATA			
TYPE OF LOG RUN (Circle One): Electric, Gamma Ray, Density, Sonic, <u>No Log Run</u> , Neutron, Other (Describe) _____			
Name of Organization Running Log			

TYPE OF COMPLETION: (Circle One or More): <u>Gravel Packed</u> , Underreamed, Telescoped, Natural Development, Open Hole, Other (Describe) _____			
---	--	--	--

GEOLOGIC DATA (Office Use Only)			
Surface Elev.	Geologic Unit	Unit Thickness	Depth to Top
Subs. SWL	Date	Analysis	Aquifer Test

WELL GROUTED TO A DEPTH OF <u>10</u> FEET
Type Grout (circle one): Cement, Bentonite, or <u>Mix</u>

Driller's Remarks			


SCREEN DATA		
Diameter - Inches <u>4</u>	Length - Feet <u>10</u>	Slot Size - Inches <u>.012</u>
Screen Type <u>PVC</u>		Depth to Bottom - Feet <u>120</u>

DESCRIPTION OF FORMATIONS ENCOUNTERED	FROM	TO
<u>Red Clay</u>	<u>0</u>	<u>20</u>
<u>Red Sand</u>	<u>20</u>	<u>106</u>
<u>Coarse Sandstone</u>	<u>106</u>	<u>120</u>

FORMATIONS (Continued)	FROM	TO
RECEIVED		
JUN 26 1995		
Dept. of Environmental Quality Office of Land & Water Resources		
IF MORE SPACE IS NEEDED, USE BACK		

If well telescopes please sketch and show depths.

GROUND LEVEL

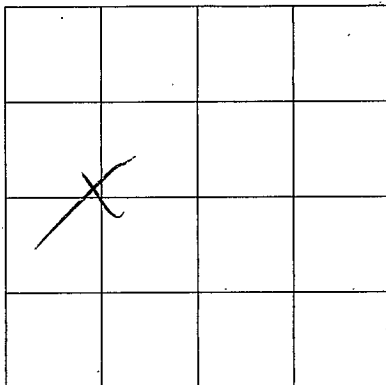

SECTION _____
Please indicate well location X.

ADDITIONAL INFORMATION

If more than one screen,
show location of each on sketch.