

**MISSISSIPPI DEPARTMENT OF ENVIRONMENTAL QUALITY**

Office of Land and Water Resources

P. O. Box 10631  
Jackson, MS 39289-0631  
**WATER WELL DRILLERS LOG**

COUNTY WELL LOCATED <i>Pike</i>	
WELL NUMBER <i>M 2110</i>	CODED
DATE WELL COMPLETED <i>4-22-99</i>	

PERMIT NUMBER
NAME OF DRILLING FIRM <i>Enterprise Well</i>

NAME & MAILING ADDRESS OF LANDOWNER <i>Emmie Clayton</i>		
<i>M. Manas Rd.</i>		
WELL LOCATION: SEC <i>20</i> TOWNSHIP <i>10 N</i> RANGE <i>9 E</i>		
DISTANCE <i>4</i> Miles	DIRECTION <i>SO</i>	NEAREST TOWN <i>Progress</i>
OTHER LANDMARK		
WELL PURPOSE <i>Home Dairy</i> Home, Irrigation, Municipal, Industrial, Fish Pond, etc.		

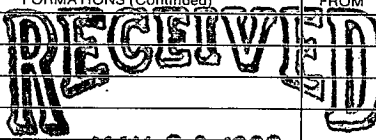
<b>PUMP DATA</b>		
PUMP TYPE (Circle One): <input checked="" type="radio"/> Submersible <input type="radio"/> Turbine <input type="radio"/> Jet <input type="radio"/> Flowing Well, Other (Describe) _____		
POWER TYPE (Circle One): <input checked="" type="radio"/> Electric <input type="radio"/> Tractor <input type="radio"/> Diesel <input type="radio"/> Gasoline <input type="radio"/> Butane, Other (Describe) _____ H/P <i>3</i>		
Pump Capacity (GPM) <i>28</i>	No. of Stages	Setting Depth <i>130'</i> FT.
PUMP TEST		
Well yielded _____ GPM with a drawdown of _____ ft. after _____ hours of pumping		

<b>WELL DATA</b>		
Well Depth <i>150</i>	Casing Diameter (In.) <i>4"</i>	Casing Length (Ft.) <i>130'</i>
Type of Casing <i>PVC</i>	Hole Depth <i>150'</i>	Depth to Static Water Level <i>80'</i>
TYPE OF COMPLETION: (Circle One or More): <input checked="" type="radio"/> Gravel Packed <input type="radio"/> Underreamed, <input type="radio"/> Telescoped, <input type="radio"/> Natural Development, <input type="radio"/> Open Hole, <input type="radio"/> Other (Describe) _____		
WELL GROUTED TO A DEPTH OF <i>10 FEET</i> Type Grout (circle one): Cement, Bentonite, <input checked="" type="radio"/> Mix		

<b>LOG DATA</b>	
TYPE OF LOG RUN (Circle One): <input checked="" type="radio"/> No Log Run <input type="radio"/> Electric, Gamma Ray, Density, Sonic, Neutron, Other (Describe) _____	
Name of Organization Running Log	

<b>SCREEN DATA</b>		
Diameter - Inches <i>4"</i>	Length - Feet <i>20</i>	Slot Size - Inches <i>0.12/0.10</i>
Screen Type <i>PVC</i>	Depth to Bottom - Feet <i>150'</i>	

<b>GEOLOGIC DATA (Office Use Only)</b>			
Surface Elev.	Geologic Unit	Unit Thickness	Depth to Top
Subs. SWL	Date	Analysis	Aquifer Test
Driller's Remarks			
Top of Lap Pipe or Reduction in Casing			
FEET		IF TELESCOPED OR MORE THAN ONE SCREEN: USE BACK PAGE	

DESCRIPTION OF FORMATIONS ENCOUNTERED	FROM	TO	FORMATIONS (Continued)	FROM	TO
<i>Top soil</i>	<i>0</i>	<i>5</i>	 <b>MAY 26 1999</b> Dept of Environmental Quality Office of Land & Water Resources		
<i>clay</i>	<i>5</i>	<i>50</i>			
<i>Sand &amp; gravel</i>	<i>50</i>	<i>100</i>			
<i>clay</i>	<i>100</i>	<i>110</i>			
<i>sand</i>	<i>110</i>	<i>130</i>			
<i>course sand &amp; gravel</i>	<i>130</i>	<i>150</i>			

IF MORE SPACE IS NEEDED, USE BACK

If well telescopes please  
sketch and show depths.

GROUND LEVEL

	X		

SECTION \_\_\_\_\_

Please indicate well location X.

ADDITIONAL INFORMATION

If more than one screen,  
show location of each on sketch.