

**MISSISSIPPI DEPARTMENT OF ENVIRONMENTAL QUALITY**

Office of Land and Water Resources

P. O. Box 10631  
Jackson, MS 39289-0631  
**WATER WELL DRILLERS LOG**

COUNTY WELL LOCATED <u>Pike</u>	
WELL NUMBER <u>M 2000</u>	CODED <u>213</u>
DATE WELL COMPLETED <u>3/9/99</u>	

PERMIT NUMBER <u>0-508</u>
NAME OF DRILLING FIRM <u>Jordan Well Ser.</u>

NAME & MAILING ADDRESS OF LANDOWNER <u>Aubrey Rimes</u>		
<u>1053 Magnolia-Progress Rd</u>		
<u>McComb, Miss</u>		
WELL LOCATION: SEC	TOWNSHIP	RANGE
<u>1</u>	<u>1</u>	<u>9</u>
	N S	E W
DISTANCE	DIRECTION	NEAREST TOWN
<u>1/4</u> Miles	<u>W</u>	<u>Progress</u>
OTHER LANDMARK		
WELL PURPOSE: Home, Irrigation, Municipal, Industrial, Fish Pond, etc. <input checked="" type="radio"/> Home		

PUMP DATA		
PUMP TYPE (Circle One): Submersible, Turbine, Jet, Flowing Well, Other (Describe) _____		
POWER TYPE (Circle One): Electric, Tractor, Diesel, Gasoline, Butane, Other (Describe) _____ H/P _____		
Pump Capacity (GPM)	No. of Stages	Setting Depth
		FT.
PUMP TEST		
Well yielded _____ GPM with a drawdown of _____ ft. after _____ hours of pumping		

WELL DATA		
Well Depth <u>114</u>	Casing Diameter (In.) <u>4</u>	Casing Length (Ft.) <u>104</u>
Type of Casing <u>Pvc</u>	Hole Depth <u>114</u>	Depth to Static Water Level <u>80</u>

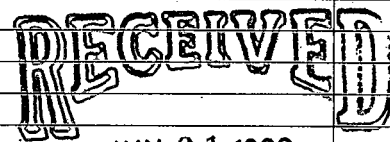
LOG DATA			
TYPE OF LOG RUN (Circle One): No Log Run, Electric, Gamma Ray, Density, Sonic, Neutron, Other (Describe) _____			
Name of Organization Running Log			

TYPE OF COMPLETION (Circle One or More): Gravel Packed, Underreamed, Telescoped, Natural Development, Open Hole, Other (Describe) _____			
WELL GROUTED TO A DEPTH OF <u>10 FEET</u> Type Grout (circle one): Cement, Bentonite, or Mix <input checked="" type="radio"/>			

GEOLOGIC DATA (Office Use Only)			
Surface Elev.	Geologic Unit	Unit Thickness	Depth to Top
Subs. SWL	Date	Analysis	Aquifer Test
Driller's Remarks			
Top of Lap Pipe or Reduction in Casing			
FEET		IF TELESCOPED OR MORE THAN ONE SCREEN: USE BACK PAGE	

SCREEN DATA		
Diameter - Inches <u>4</u>	Length - Feet <u>10</u>	Slot Size - Inches <u>.010</u>
Screen Type <u>Pvc</u>	Depth to Bottom - Feet <u>94</u>	

DESCRIPTION OF FORMATIONS ENCOUNTERED	FROM	TO
<u>Top Soil</u>	<u>0</u>	<u>1</u>
<u>Sandy Clay</u>	<u>1</u>	<u>35</u>
<u>Dry Gravel</u>	<u>35</u>	<u>60</u>
<u>Shale</u>	<u>60</u>	<u>85</u>
<u>Sand</u>	<u>85</u>	<u>114</u>

FORMATIONS (Continued)	FROM	TO
 JUN 21 1999 Dept of Environmental Quality Office of Land & Water Resources		

IF MORE SPACE IS NEEDED, USE BACK

If well telescopes please  
sketch and show depths.

GROUND LEVEL

			X

SECTION 1

Please indicate well location X.

ADDITIONAL INFORMATION

If more than one screen,  
show location of each on sketch.