

# MISSISSIPPI DEPARTMENT OF ENVIRONMENTAL QUALITY

Office of Land and Water Resources

P. O. Box 10631  
Jackson, MS 39289-0631  
WATER WELL DRILLERS LOG

COUNTY WELL LOCATED <i>Pike</i>	
WELL NUMBER <i>M 2129</i>	CODED
DATE WELL COMPLETED <i>3-24-00</i>	

PERMIT NUMBER
NAME OF DRILLING FIRM <i>Etzosa &amp; Well Serv.</i>

NAME & MAILING ADDRESS OF LANDOWNER <i>Clifton Loveless</i>			
<i>Silver Dr.</i>			
WELL LOCATION:	SEC <i>15</i>	TOWNSHIP <i>1</i>	RANGE <i>N 9 E</i>
DISTANCE <i>3</i> Miles	DIRECTION <i>East</i>	NEAREST TOWN <i>Progress</i>	
OTHER LANDMARK			
WELL PURPOSE: <input checked="" type="checkbox"/> Home Irrigation, Municipal, Industrial, Fish Pond, etc.			

PUMP DATA		
PUMP TYPE (Circle One): Submersible, Turbine, Jet, Flowing Well, Other (Describe) _____		
POWER TYPE (Circle One): Electric, Tractor, Diesel, Gasoline, Butane, Other (Describe) _____ H/P _____		
Pump Capacity (GPM)	No. of Stages	Setting Depth <i>FT.</i>
PUMP TEST Well yielded _____ GPM with a drawdown of _____ ft. after _____ hours of pumping		

WELL DATA		
Well Depth <i>115'</i>	Casing Diameter (In.) <i>4"</i>	Casing Length (Ft.) <i>105'</i>
Type of Casing <i>PVC</i>	Hole Depth <i>115'</i>	Depth to Static Water Level <i>78'</i>
TYPE OF COMPLETION: (Circle One or More): <input checked="" type="checkbox"/> Gravel Packed, <input type="checkbox"/> Underreamed, <input type="checkbox"/> Telescoped, <input type="checkbox"/> Natural Development, <input type="checkbox"/> Open Hole, <input type="checkbox"/> Other (Describe) _____		
WELL GROUTED TO A DEPTH OF <i>10</i> FEET Type Grout (circle one): Cement, Bentonite, <input checked="" type="checkbox"/> Mix		

LOG DATA	
TYPE OF LOG RUN (Circle One): No Log Run, Electric, Gamma Ray, Density, Sonic, Neutron, Other (Describe) _____	
Name of Organization Running Log	

SCREEN DATA		
Diameter - Inches <i>4"</i>	Length - Feet <i>10</i>	Slot Size - Inches <i>.012</i>
Screen Type <i>PVC</i>	Depth to Bottom - Feet <i>115'</i>	

GEOLOGIC DATA (Office Use Only)			
Surface Elev.	Geologic Unit	Unit Thickness	Depth to Top
Subs. SWL	Date	Analysis	Aquifer Test
Driller's Remarks			
Top of Lap Pipe or Reduction in Casing			
FEET		IF TELESCOPED OR MORE THAN ONE SCREEN: USE BACK PAGE	


DESCRIPTION OF FORMATIONS ENCOUNTERED	FROM TO		FORMATIONS (Continued)	FROM TO	
	FROM	TO		FROM	TO
<i>clay</i>	<i>0</i>	<i>30</i>			
<i>sand &amp; gravel</i>	<i>30</i>	<i>90</i>			
<i>course sand</i>	<i>90</i>	<i>115</i>			

REC'D JUN 21 2001

IF MORE SPACE IS NEEDED, USE BACK

If well telescopes please  
sketch and show depths.

GROUND LEVEL

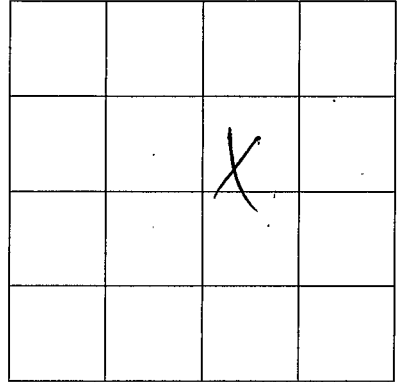

SECTION 15

Please indicate well location X.

ADDITIONAL INFORMATION

If more than one screen,  
show location of each on sketch.