

MISSISSIPPI DEPARTMENT OF ENVIRONMENTAL QUALITY

Office of Land and Water Resources

P. O. Box 10631  
Jackson, MS 39289-0631  
WATER WELL DRILLERS LOG

COUNTY/WELL LOCATED  
**PIKE**

WELL NUMBER  
**M-2130**

CODED

PERMIT NUMBER  
**0-287**

NAME OF DRILLING FIRM  
**REEVES WELL SER.**

DATE WELL COMPLETED  
**6-7-99**

NAME & MAILING ADDRESS OF LANDOWNER  
**JAMES CROSSLEY JR.**

**4031 Pumping Station Rd**

**OSGMA MISS.**

WELL LOCATION: SEC **18** TOWNSHIP **1** RANGE **9**

DISTANCE **8** Miles DIRECTION **SE** of NEAREST TOWN **MAGNOLIA**

OTHER LANDMARK

WELL PURPOSE: Home, Irrigation, Municipal, Industrial, Fish Pond, etc.

PUMP DATA

PUMP TYPE (Circle One):  
Submersible, Turbine, Jet, Flowing Well,  
Other (Describe)

POWER TYPE (Circle One):  
Electric, Tractor, Diesel, Gasoline, Butane,  
Other (Describe) H/P

Pump Capacity (GPM) **10** No. of Stages **8** Setting Depth **100** FT.

PUMP TEST  
Well yielded **50** GPM with  
a drawdown of **0** ft.  
after **1** hours of pumping

WELL DATA

Well Depth <b>120'</b>	Casing Diameter (In.) <b>4"</b>	Casing Length (Ft.) <b>20'</b>
Type of Casing <b>PVC</b>	Hole Depth <b>120'</b>	Depth to Static Water Level <b>80'</b>

TYPE OF COMPLETION: (Circle One or More):  
Gravel Packed, Underreamed, Telescoped,  
Natural Development, Open Hole, Other:  
(Describe) **LOCAL SAND**

WELL GROUTED TO A DEPTH OF **10** FEET  
Type Grout (circle one): Cement, Bentonite, or Mix

LOG DATA

TYPE OF LOG RUN (Circle One): No Log Run,  
Electric, Gamma Ray, Density, Sonic, Neutron,  
Other (Describe)

Name of Organization Running Log

GEOLOGIC DATA (Office Use Only)

Surface Elev.	Geologic Unit	Unit Thickness	Depth to Top
Subs. SWL	Date	Analysis	Aquifer Test

SCREEN DATA

Diameter - Inches <b>4"</b>	Length - Feet <b>10'</b>	Slot Size - Inches <b>10 Slot</b>
Screen Type <b>PVC</b>	Depth to Bottom - Feet <b>120'</b>	

Driller's Remarks  
**REC'D JAN 03 2002**

Top of Lap Pipe or Reduction in Casing


FEET IF TELESKOPED OR MORE THAN ONE SCREEN: USE BACK PAGE

DESCRIPTION OF FORMATIONS ENCOUNTERED	FROM	TO	FORMATIONS (Continued)	FROM	TO
<b>CLAY</b>	<b>0</b>	<b>18</b>			
<b>SAND</b>	<b>18</b>	<b>60</b>			
<b>SAND &amp; GRAVEL</b>	<b>60</b>	<b>90</b>			
<b>CHALKY SAND</b>	<b>90</b>	<b>105</b>			
<b>SAND &amp; PEAGRAVEL</b>	<b>105</b>	<b>120</b>			

IF MORE SPACE IS NEEDED, USE BACK

If well telescopes please  
sketch and show depths.

GROUND LEVEL

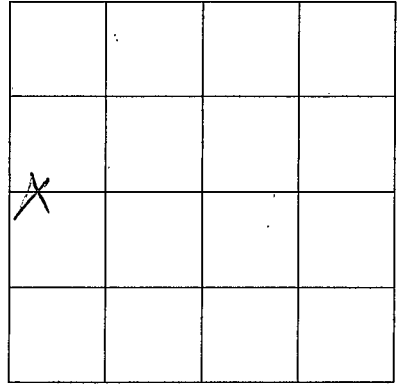

SECTION 18

Please indicate well location X.

ADDITIONAL INFORMATION

If more than one screen,  
show location of each on sketch.