


J. W. WEBB & SONS, INC.

WELL AND PUMP DATA SHEET

JOB IDENTIFICATION Mud Creek Well # 1 DATE _____

CUSTOMER _____

ADDRESS Pontotoc City, Miss.

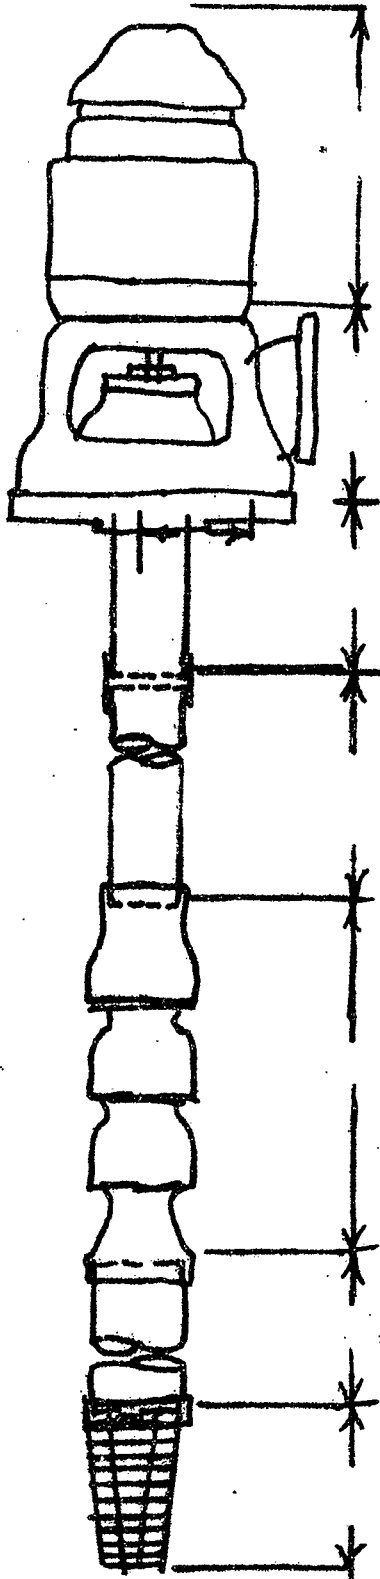

WELL DATA:

DIAMETER CASING 8"
 LENGTH CASING 1085
 DIA. & LENGTH SCREEN 4" X 100'
 TOTAL DEPTH WELL 1260'
 DIA. & LENGTH UNDERREAM _____
 SLOT SCREEN 12
 SIZE GRAVEL _____
 STATIC WATER LEVEL 201
 DRAWDOWN 300'
 HEAD AT PUMP DISCHARGE 60#
 DRILLER Johnny Webb

PUMP DATA:

TOTAL HEAD 320 below / 60 above
 CAPACITY 250 g.p.m.
 R.P.M. 1850
 TYPE Oil-like Turbine
 MANUFACTURER Flow-Way
 BOWL EFFICIENCY _____
 BHP — NOT INCLUDING _____
 SHAFT & COLUMN LOSSES _____
 HEAD & DISCHARGE SIZE 4"
 BOWLS 8"
 STAGES 15
 COLUMN SIZE 5"
 SHAFT SIZE 1 1/2"
 OIL TUBING SIZE 2"
 SUCTION PIPE SIZE _____
 PUMP SERIAL NO. _____
 MOTOR SERIAL NO. _____
 MOTOR SIZE & MAKE 40 H.P. US
 CURRENT 230 3 phase
 SIZE OF CONTROL PANEL 4
 CONTROL PANEL MFG. Allen Bradley
Pressure Tank 10,000 gal.
Chlorine Booster 1 1/2 H.P.
Joint.

*29851E
A*

DEPT. OF NATURAL RESOURCES
 BUREAU OF LAND & WATER RESOURCES

NOV 25 1981

RECEIVED



J. W. Webb & Sons, Inc. • Box 88 • Belden, Miss. 38826

