

**PONTOTOC**  
A 16  
11-13-69

MISSISSIPPI  
 BOARD OF WATER COMMISSIONERS  
 416 North State Street  
 Jackson, Mississippi 39201

WATER WELL DRILLERS LOG

11-13 1969 Ed Clark Contracting Corp  
 date well completed firm name county well located

LANDOWNER:  
Joe Foley  
Ethel - Route  
 (mailing address)

description of formations encountered	from	to
<u>Clay</u>	<u>0</u>	<u>20</u>
<u>Rock &amp; Sand</u>	<u>20</u>	<u>70</u>
<u>Blue mud</u>	<u>70</u>	<u>460</u>
<u>Sand</u>	<u>460</u>	<u>500</u>

WELL LOCATION:  
 sec. 8 T. 8 N. R. 1 E  
14 miles South of Ethel  
 (distance) (direction) (nearest town)

WELL PURPOSE: None  
 (home, irrigation, municipal, industrial)

WELL COMPLETION DATA:

(1) diameter (inches) 4"

(2) total depth (feet) 500'

(3) static water level (feet) 70' below above top of ground.

(4) casing Metal, 149'  
 (material) (depth)  
4" if telescope see back.  
 (size)

(5) screen None  
 (length) (depth to top)  
 (size) (material)

(6) pump 1/2 Sub. 8  
 (HP) (yield gpm)  
Electric  
 (type power)

(7) electric log no  
 (yes or no)  
 (organization running log)


(8) how well bottom plugged.

DRILLERS REMARKS:

NOV 17 1969  
 MISS. Bd. OF WATER COMMISSIONERS

If well telescopes please sketch and show depths.

GROUND LEVEL

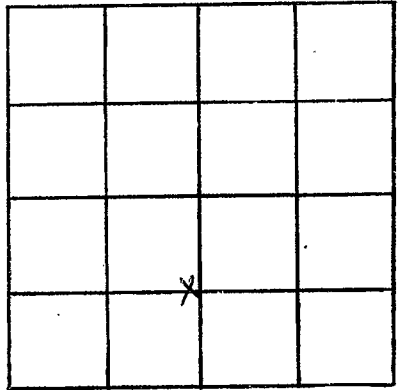

SECTION \_\_\_\_\_

Please indicate well location X.

ADDITIONAL INFORMATION

If more than one screen,  
show locations of each on sketch.