

PONTOTOC
A 17
4-14-71

MISSISSIPPI
BOARD OF WATER COMMISSIONERS
416 North State Street
Jackson, Mississippi 39201

CODED

WATER WELL DRILLERS LOG

4-14-1971 Leeper Drilling Co Pontotoc
 Date well completed firm name county well located

LANDOWNER:

Burlon Guillan
RT-1 - Thaxton
(mailing address)

description of formations encountered

	from	to
<u>Red clay + red sand</u>	<u>0</u>	<u>60</u>
<u>Blue clay</u>	<u>60</u>	<u>200</u>
<u>Chalky clay</u>	<u>200</u>	<u>350</u>
<u>Sand</u>	<u>350</u>	<u>495</u>

WELL LOCATION:

sec. 21 T. 8 N. R. 1 E.
S. 10 miles nw of Pontotoc
(distance) (direction) (nearest town)

WELL PURPOSE:

home
(home, irrigation, municipal, industrial)

WELL COMPLETION DATA:

- (1) diameter (inches) 4
- (2) total depth (feet) 495
- (3) static water level (feet) 120 below above top of ground.
- (4) casing Steel, 84,
(material) (depth)
4 if telescope see back.
(size)
- (5) screen open
(length) (depth to top)
(size) (material)
- (6) pump 3/4 9
(HP) (yield gpm)
Elect
(type power)
- (7) electric log no
(yes or no)
(organization running log)
- (8) how well bottom plugged open

CODED


MAY 14 1971

DRILLERS REMARKS:

MISS. BD. OF
WATER COMMISSIONERS

If well telescopes please sketch and show depths.

GROUND LEVEL

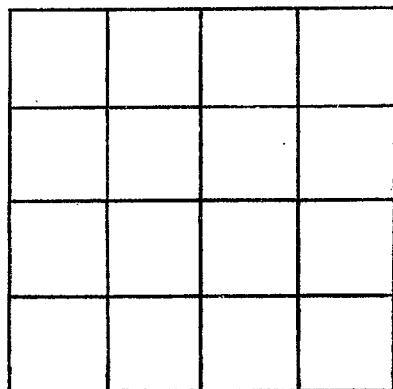

SECTION _____

Please indicate well location X.

ADDITIONAL INFORMATION

If more than one screen, show locations of each on sketch.