

PONTOTOC

A18

4-17-71

MISSISSIPPI
 BOARD OF WATER COMMISSIONERS
 416 North State Street
 Jackson, Mississippi 39201

CODED

WATER WELL DRILLERS LOG

4-17-1961
date well completed

Leepul Drilling Co.
firm name

Pontotoc
county well located

LANDOWNER:

Bobby Todd
Rt 1 - Thaxton
(mailing address)

description of formations encountered

	from	to
Red Clay + Red Sand	0	60
Blue Clay	60	200
Chalk & Clay	200	350
Sand	350	495

WELL LOCATION:

sec. 21 T. 8 S. R. 1 E
10 miles N.W. of Pontotoc
(distance) (direction) (nearest town)

WELL PURPOSE:

home
(home, irrigation, municipal, industrial)

WELL COMPLETION DATA:

- (1) diameter (inches) 4
- (2) total depth (feet) 495
- (3) static water level (feet) 120 below top of ground.
- (4) casing Steel, 84 (material) (depth)
- (size) if telescope see back.
- (5) screen open (length) (depth to top)
- (size) (material)
- (6) pump 3/4 (HP) 9 (yield gpm)
- Elect (type power)
- (7) electric log no- (yes or no)

CODED

(organization running log)

(8) how well bottom plugged


DRILLERS REMARKS:

MAY 11 1971

MISS. BD. OF
WATER

If well telescopes please sketch and show depths.

GROUND LEVEL

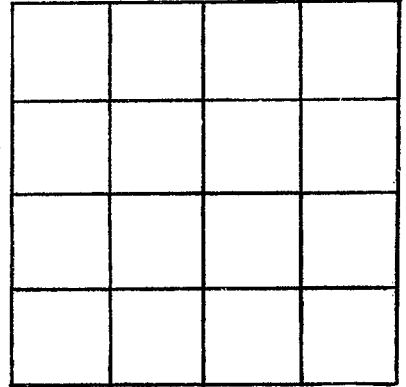

SECTION _____

Please indicate well location X.

ADDITIONAL INFORMATION

If more than one screen, show locations of each on sketch.