

CODED

CODED

Pontotoc
A-20
5-68

MISSISSIPPI
BOARD OF WATER COMMISSIONERS
416 North State Street
Jackson, Mississippi 39201

WATER WELL DRILLERS LOG

MAY 6 - 1968 date well completed LAMAN WILDER firm name PONTOTOC county well located

LANDOWNER:
HOOKER
THAYTON MISS
(mailing address)

description of formations encountered	from	to
GREY BUCKSHOT	0	20
BLUE SHALE	20	320
ROCK & SAND	320	408

WELL LOCATION:
sec. 9 T 9 S R 1 E
6 miles W of FLOW
(distance) (direction) (nearest town)

WELL PURPOSE:
(home, irrigation, municipal, industrial)

THIS WELL DRILLED FOR SUB-CONTRACTOR -

WELL COMPLETION DATA:

- (1) diameter (inches) 4
- (2) total depth (feet) 408
- (3) static water level (feet) NOT KNOWN below top of ground.
- (4) casing STEEL, 80' (material), (depth)
4" (size) if telescope see back.
- (5) screen (length) (depth to top)
(size) (material)
- (6) pump (HP) (yield gpm)
(type power)
- (7) electric log (yes or no)
(organization running log)
- (8) how well bottom plugged

SIZE OF PUMP FLOW OF WATER ETC - NOT AVAILABLE AS OF 7-5-68


CODED

JUL - 2 1968
MISS. BOARD OF
WATER COMMISSIONERS

DRILLERS REMARKS:
PUMP SOL & BY OTHERS -
NOT INSTALLED 5-68

If well telescopes please sketch and show depths.

GROUND LEVEL

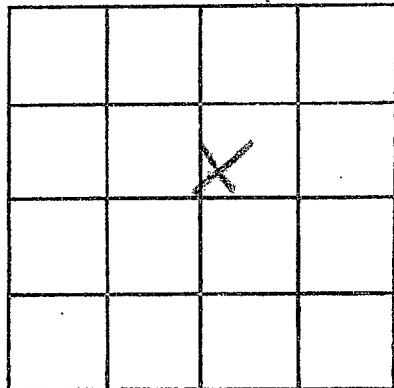

SECTION _____

Please indicate well location X.

ADDITIONAL INFORMATION

If more than one screen, show locations of each on sketch.

11/1/54