

CODED

CODED

MISSISSIPPI
 BOARD OF WATER COMMISSIONERS
 416 North State Street
 Jackson, Mississippi 39201

WATER WELL DRILLERS LOG

Pontotoc
 A-21
 5-68

MAY 13 19 2 AMAT WILDER PONTOTOC
 date well completed firm name county well located

LANDOWNER:

NOT KNOWN

description of formations encountered

from to

NOT KNOWN

RED SAND
 BLUE SAND
 ROCK & SAND

0 30
 30 340
 340 420

(mailing address)

WELL LOCATION:

sec 23 T 2 N R 1 E
 S WF
 8 miles W of ECHO
 (distance) (direction) (nearest town)

WELL PURPOSE:

(home, irrigation, municipal, industrial)

1

WELL COMPLETION DATA:

- (1) diameter (inches) 4
- (2) total depth (feet) 420
- (3) static water level (feet) not known below above top of ground
- (4) casing STEEL, 34 (material), (depth)
4 1/2 (size) if telescope see back.
- (5) screen (length) (depth to top)
 (size) (material)
- (6) pump (HP) (yield gpm)
 (type power)
- (7) electric log (yes or no)
 (organization running log)
- (8) how well bottom plugged

THIS WELL DRILLED FOR SUB-CONTRACTOR
 OTHER INFORMATION NOT KNOWN




JUL 8 1968
 MISS. BOARD OF WATER COMMISSIONERS

DRILLERS REMARKS:

If well telescopes please sketch and show depths.

GROUND LEVEL

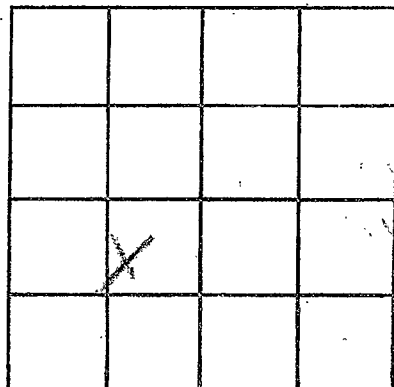

SECTION _____

Please indicate well location X.

ADDITIONAL INFORMATION

If more than one screen,
show locations of each on sketch.