

CODED

Pontotoc
A 22
8-20-68

MISSISSIPPI
 BOARD OF WATER COMMISSIONERS
 416 North State Street
 Jackson, Mississippi 39201

WATER WELL DRILLERS LOG

8-20 1968 Clark Bros. Pontotoc
 date well completed firm name county well located

LANDOWNER:
Lake Russell
Pontotoc Rt.
 (mailing address)


description of formations encountered	from	to
<u>Red clay</u>	<u>0</u>	<u>22</u>
<u>Sand</u>	<u>22</u>	<u>90</u>
<u>Blue mud & shell</u>	<u>90</u>	<u>120</u>
<u>Blue mud</u>	<u>120</u>	<u>490</u>
<u>Rocky sand</u>	<u>490</u>	<u>550</u>

WELL LOCATION:
 sec. 34 T 90 R 1 E
12 miles W of Pontotoc
 (distance) (direction) (nearest town)

WELL PURPOSE: Home
 (home, irrigation, municipal, industrial)

- WELL COMPLETION DATA:
- (1) diameter (inches) 4"
 - (2) total depth (feet) 550'
 - (3) static water level (feet) 160' below above top of ground.
 - (4) casing metal, 150',
 (material) (depth)
4"
 (size) if telescope see back.
 - (5) screen None
 (length) (depth to top)
 (size) (material)
 - (6) pump 2 pet 5
 (HP) (yield gpm)
Electric
 (type power)
 - (7) electric log no
 (yes or no)
 (organization running log)
 - (8) how well bottom plugged no

CODED

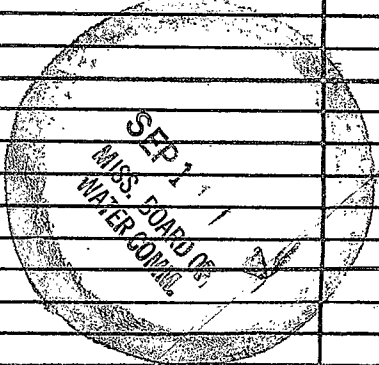

DRILLERS REMARKS:

