

MISSISSIPPI BOARD OF WATER COMMISSIONERS

PONTOTOC
A24
8-7-61

WATER WELL DRILLERS LOG

CODED

Date: 8/7, 1961, Driller: ELLIOTT HARDWARE COMPANY
OXFORD, MISSISSIPPI

(1) Owner of Land: J. D. Brown
(Name)
Thaxton
(Address)

(2) Location: 1/4, 8 1/4, Sec. 13 T8 R10
18 miles East of Pyrid
(distance) (direction) (Nearest Town)

(3) Topography: Hilly
(Hilly) (Flat) (Level)

(4) Purpose of Well: Domestic
(Domestic Irrigation
Municipal, Industrial, Other)

Description & Color of Materials Sand, Clay, Red Clay, Shell, etc.	Thick- ness Feet	Depth Feet
<u>Clay -</u>	<u>20</u>	<u>20</u>
<u>Blue clay</u>	<u>21</u>	<u>41</u>
<u>Hard Black</u>	<u>18</u>	<u>59</u>
<u>Green + Blue</u>	<u>44</u>	<u>105</u>
<u>Fine White Sand</u>	<u>21</u>	<u>126</u>

Information upon completion of well:

(1) Diameter 2 inches.

(2) Total Depth 126 feet.


(3) Water Level 45 feet below top of ground.

(4) Cased to 63, Size 4"

(5) Screen: Size no, Length _____

(6) Were any formations sealed against pollution?
_____ yes, _____ no.

CODED

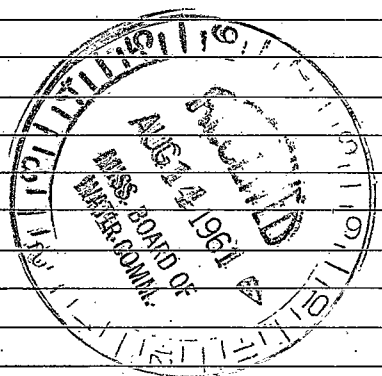

If YES depth of formation _____

Why _____

Drillers Remarks: _____

(Use Back Side)

Well No.

1900

1900