

PONTOTOC
A 25
6-1-63

MISSISSIPPI BOARD OF WATER COMMISSIONERS

WATER WELL DRILLERS LOG

CODED

Date: June 1, 1963, Driller: Ed C. Cof County union
(Name)

(1) Owner of Land:	Description & Color of Materials Sand, Clay, Red Clay, Shell, etc.	Thick- ness Feet	Depth Feet
<u>Reno Graham</u> (Name) <u>Pontotoc miss</u> (Address)	<u>Red clay</u>	<u>20</u>	<u>20</u>
(2) Location: <u>1/4</u> , <u>1/4</u> , Sec. <u>191</u>	<u>Blue mof</u>	<u>140</u>	<u>40</u>
<u>12</u> miles <u>west</u> , of <u>Pontotoc</u> (distance) (direction) (Nearest Town)	<u>Rock 208</u>	<u>29</u>	<u>260</u>
(3) Topography: <u>Flat</u> (Hilly) (Flat) (Level)			
(4) Purpose of Well: <u>Home use</u> (Domestic Irrigation Municipal, Industrial, Other)			

Information upon completion of well:


- (1) Diameter 4 inches.
- (2) Total Depth 29 feet.
- (3) Water Level 40 feet below top of ground.
- (4) Cased to 64, Size 4.
- (5) Screen: Size 0, Length _____.
- (6) Were any formations sealed against pollution?
_____ yes, X no.

If YES depth of formation _____

Why _____

Drillers Remarks: _____

CODED

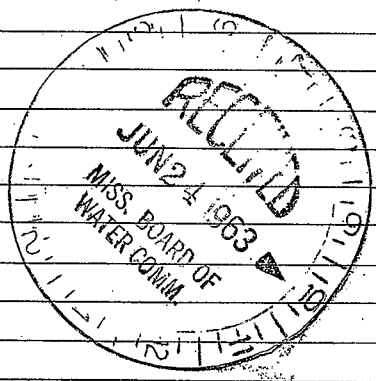

(Use Back Side)

Well No.

