

A 28

9-65

WATER WELL DRILLERS LOG

**CODED**

Date: Sept, 1965, Driller: Johnny Webb County Pontotoc  
 (Name)

	Description & Color of Materials Sand, Clay, Red Clay, Shell, etc.	Thick- ness Feet	Depth Feet
(1) Owner of Land: <u>Wayne Bost</u> (Name) <u>Zhoton, Miss.</u> (Address)	<u>Sand &amp; clay to 40'</u>		
	<u>sand 40' to 150'</u>		
(2) Location: <u>1/4, SE 1/4, Sec. 9 T9R1</u>	<u>Blue clay 150 to 195'</u>		
<u>1 1/2 miles West</u> of <u>Zhoton</u>	<u>Blue mud 195 to 480'</u>		
(distance) (direction) (Nearest Town)	<u>Water sand 480 to 590'</u>		
(3) Topography: <u>X</u>			
(Hilly) (Flat) (Level)			
(4) Purpose of Well: <u>Domestic</u>			
(Domestic Irrigation Municipal, Industrial, Other)			

Information upon completion of well:

(1) Diameter 4 inches.

(2) Total Depth 590' feet.

(3) Water Level 180' feet below top of ground.

(4) Cased to 212', Size 4"


(5) Screen: Size \_\_\_\_\_, Length \_\_\_\_\_

(6) Were any formations sealed against pollution?  
 \_\_\_\_\_ yes, \_\_\_\_\_ no.

If YES depth of formation \_\_\_\_\_  
 Why \_\_\_\_\_

Drillers Remarks: Very coarse sand  
from 40' to 100'

**CODED**

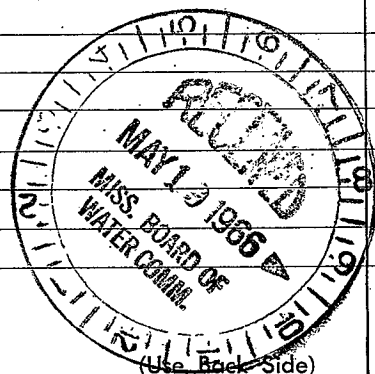

Well No.

1904

1904

1904