

PONTOTOC
A 29
8-8-61

WATER WELL DRILLERS LOG

CODED

Date: 8/8, 1961, Driller: ELLIOTT HARDWARE COMPANY County: Yazoo
Name: MISSISSIPPI

(1) Owner of Land: Floyd Gardner
(Name)
Thaxton, Miss
(Address)

(2) Location: 1/4, SW 1/4, Sec. 11 T25R16W
18 miles East of Oxford
(distance) (direction) (Nearest Town)

(3) Topography: Hilly
(Hilly) (Flat) (Level)

(4) Purpose of Well: Domestic
(Domestic Irrigation
Municipal, Industrial, Other)

Description & Color of Materials Sand, Clay, Red Clay, Shell, etc.	Thick- ness Feet	Depth Feet
Clay	18	18
Blue Clay	15	33
SINE Mica	5	38
Blue Clay	7	45
Black Clay "Hard"	12	57
White Clay	3	60
Green	18	78
Blue	8	86
Mica Sand	14	100
Blue -	5	105
White Sand + Clay	15	120
Hard - Blue	80	200

Information upon completion of well:

(1) Diameter 2 inches.

(2) Total Depth 200 feet.

(3) Water Level 98 feet below top of ground.


(4) Cased to 84, Size 4.

(5) Screen: Size No, Length .

(6) Were any formations sealed against pollution?
_____ yes, _____ no.

CODED

If YES depth of formation _____
Why _____
Drillers Remarks: _____

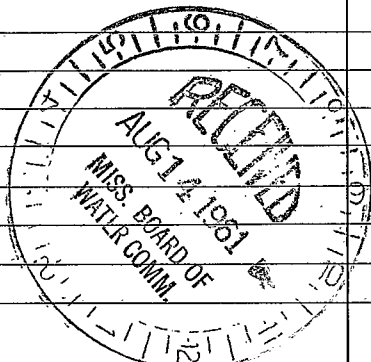

(Use Back Side)

Well No.

01309

01309