

**Pontotoc**  
**A 31**  
**12-1-71**

MISSISSIPPI  
 BOARD OF WATER COMMISSIONERS  
 416 North State Street  
 Jackson, Mississippi 39201

WATER WELL DRILLERS LOG

12-1-1971 date well completed  
 Leeper Drilling Co. firm name  
 Pontotoc county well located

LANDOWNER:  
 Wayne Wood  
 Rt. 1 Shopton, Miss.  
 (mailing address)

description of formations encountered	from	to
Red clay & Red sand	0	40
Red sand & Blue clay	40	90
Blue clay & Rock	90	225
Blue clay & Chalk	225	360
Sand	360	465

WELL LOCATION:  
 sec. 35 T. 8 S. R. 1 E.  
 10 miles W of Pontotoc  
 (distance) (direction) (nearest town)

WELL PURPOSE: home  
 (home, irrigation, municipal, industrial)

- WELL COMPLETION DATA:
- (1) diameter (inches) 4
  - (2) total depth (feet) 465
  - (3) static water level (feet) 105 below above top of ground.
  - (4) casing Steel, 105,  
 (material) (depth)  
4 if telescope see back.  
 (size)
  - (5) screen open  
 (length) (depth to top)  
 (size) (material)
  - (6) pump 3/4 7  
 (HP) (yield gpm)  
Elect  
 (type power)
  - (7) electric log no  
 (yes or no)  
 (organization running log)
  - (8) how well bottom plugged open


DRILLERS REMARKS:

JAN 10 1972

MADE BY  
 PONTOTOC

If well telescopes please sketch and show depths.

GROUND LEVEL

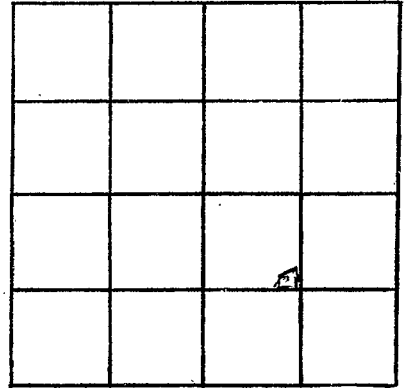

SECTION 35

Please indicate well location X.

ADDITIONAL INFORMATION

If more than one screen, show locations of each on sketch.