

PONTOTOC
A 32
11-15-71

MISSISSIPPI
 BOARD OF WATER COMMISSIONERS
 416 North State Street
 Jackson, Mississippi 39201

WATER WELL DRILLERS LOG

11-15-71 19 Leepul Drilling Co - Pontotoc
 date well completed firm name county well located

LANDOWNER: Lynn Sanders

description of formations encountered	from	to
Red clay & Red sand	0	30
Red sand & Blue clay	30	80
Strip of Red clay & Blue clay	80	105
Blue clay & Chalk	105	300
Chalk	300	350
Sand	350	450

Thaxton, Miss
 (mailing address)

WELL LOCATION:
 sec. 3 T. 9 S. R. 1 E.
7 miles W of Pontotoc
 (distance) (direction) (nearest town)

WELL PURPOSE: Home
 (home, irrigation, municipal, industrial)

WELL COMPLETION DATA:

- (1) diameter (inches) 4
- (2) total depth (feet) 450
- (3) static water level (feet) 80 below above top of ground.
- (4) casing steel, 105',
 (material) (depth)
- 4
 (size) if telescope see back.
- (5) screen open,
 (length) (depth to top)
- (size) (material)
- (6) pump 3/4 7
 (HP) (yield gpm)
- Elect
 (type power)
- (7) electric log no
 (yes or no)

(organization running log)

(8) how well bottom plugged open


DRILLERS REMARKS:

JAN 10 1972

MISS. BD. OF
 WATER COM.

If well telescopes please sketch and show depths.

GROUND LEVEL

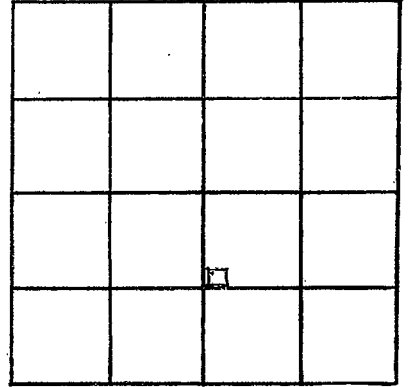

SECTION 3

Please indicate well location X.

ADDITIONAL INFORMATION

If more than one screen,
show locations of each on sketch.