

PONTOTOC
 BA33
 4-21-72

MISSISSIPPI
 BOARD OF WATER COMMISSIONERS
 416 North State Street
 Jackson, Mississippi 39201

WATER WELL DRILLERS LOG

April 21 1972 Leeper Drilling Co.

Pontotoc
 county well located


date well completed RAY Leeper, Jr. firm name

LANDOWNER:	description of formations encountered	from	to
Billy Hughes Rt. 5 PONTOTOC (mailing address)		Sandy clay Blue clay - Clay & Chalk Sand -	0 40 84 200
WELL LOCATION:			
sec. <u>31</u> T <u>9</u> N R <u>1</u> E <u>6</u> miles <u>West</u> of <u>Pontotoc</u> (distance) (direction) (nearest town)			
WELL PURPOSE: <u>Home</u> (home, irrigation, municipal, industrial)			
WELL COMPLETION DATA:			
(1) diameter (inches) <u>4"</u>			
(2) total depth (feet) <u>288'</u>			
(3) static water level (feet) <u>150'</u> <input checked="" type="checkbox"/> below <input type="checkbox"/> above top of ground.			
(4) casing <u>Steel</u> <u>84</u> (material) (depth) <u>4"</u> if telescope see back. (size)			
(5) screen <u>NONE</u> (length) (depth to top) (size) (material)			
(6) pump <u>1/2</u> <u>76 GPM</u> (HP) (yield gpm) <u>electric</u> (type power)			
(7) electric log <u>NO</u> (yes or no) (organization running log)			
(8) how well bottom plugged <u>OPEN</u>			
DRILLERS REMARKS:			

JUL 12 1972

If well telescopes please sketch and show depths.

GROUND LEVEL

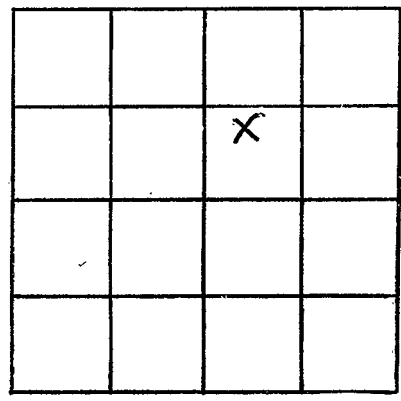

SECTION 31

Please indicate well location X.

ADDITIONAL INFORMATION

Lined area for additional information.

If more than one screen, show locations of each on sketch.